


QTY -051	P/N	DESCRIPTION	SUPPLIER
X	DT10745-051	VALVE TEST FIXTURE ASSEMBLY	
1	DT10745-1	BASE	
1	DT10745-3	SUPPORT	
1	DT10745-5	SUPPORT	
1	DT10745-7	LOAD CELL SUPPORT	
1	DT10745-21	COVER	
1	1789N15	ROCKER SWITCH	MCMaster CARR
1	1789N326	CAP, ROCKER SWITCH, ARROWS	MCMaster CARR
1	6530K931	HIGH-FORCE ELECTRIC ACTUATOR	MCMaster CARR
1	90905A651	SPLIT RING	MCMaster CARR
1	97840A460	LANYARD TAB	MCMaster CARR
1	D2690-6	LANYARD	
1	DPM-3	LOAD CELL DISPLAY	TRANSDUCER TECHNIQUES
1	MS17984C4-10	QUICK PIN, ROUND HEAD, 0.25 X 1.0	
2	MS21209F4-15	HELICOIL	
5	MS35206-261	SCREW #10	
9	NAS1351C4-12	SOCKET HEAD CAP SCREW	

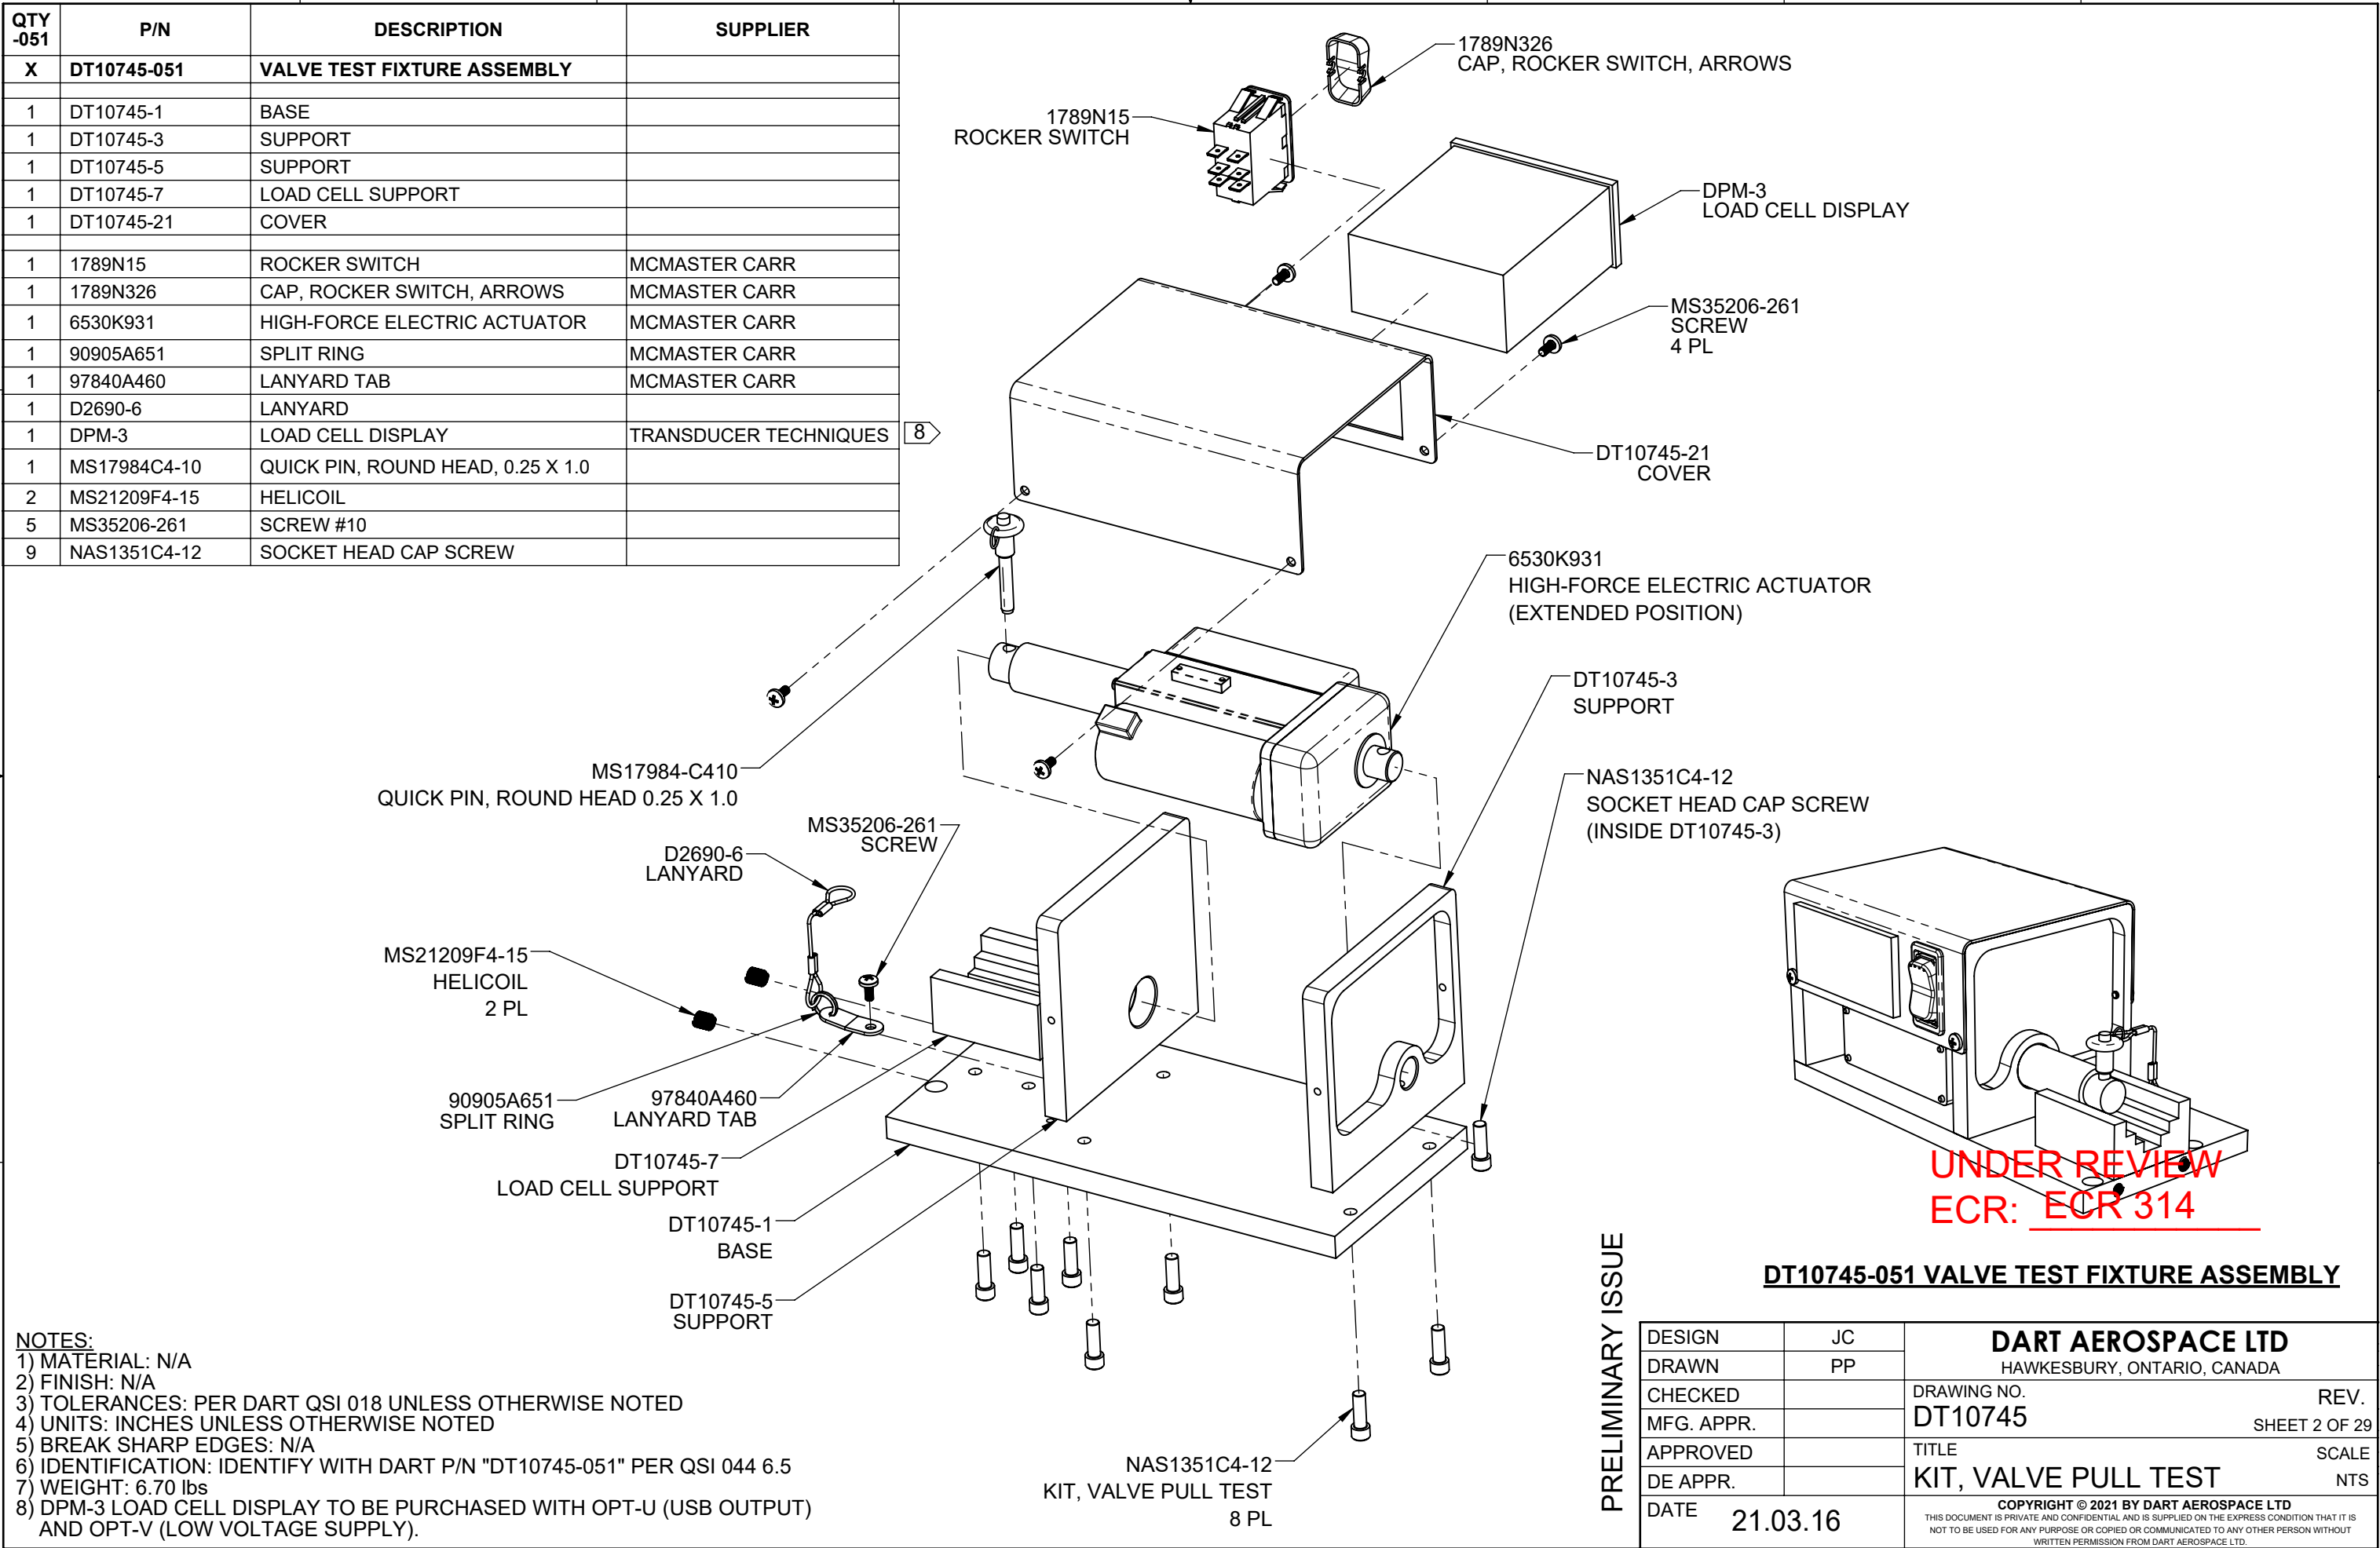

NOTES:
1) MATERIAL: N/A
2) FINISH: N/A
3) TOLERANCES: PER DART QSI 018 UNLESS OTHERWISE NOTED
4) UNITS: INCHES UNLESS OTHERWISE NOTED
5) BREAK SHARP EDGES: N/A
6) IDENTIFICATION: IDENTIFY WITH DART P/N "DT10745-051" PER QSI 044 6.5
7) WEIGHT: 6.70 lbs
8) DPM-3 LOAD CELL DISPLAY TO BE PURCHASED WITH OPT-U (USB OUTPUT) AND OPT-V (LOW VOLTAGE SUPPLY).



UNDER REVIEW
ECR: ECR 314

DT10745-051 VALVE TEST FIXTURE ASSEMBLY

DESIGN	JC	DART AEROSPACE LTD HAWKESBURY, ONTARIO, CANADA	
DRAWN	PP		
CHECKED		DRAWING NO. DT10745	REV. SHEET 2 OF 29
MFG. APPR.		TITLE KIT, VALVE PULL TEST	SCALE NTS
APPROVED		<small>COPYRIGHT © 2021 BY DART AEROSPACE LTD THIS DOCUMENT IS PRIVATE AND CONFIDENTIAL AND IS SUPPLIED ON THE EXPRESS CONDITION THAT IT IS NOT TO BE USED FOR ANY PURPOSE OR COPIED OR COMMUNICATED TO ANY OTHER PERSON WITHOUT WRITTEN PERMISSION FROM DART AEROSPACE LTD.</small>	
DE APPR.			
DATE	21.03.16		

PRELIMINARY ISSUE

QTY -055	P/N	DESCRIPTION	SUPPLIER
X	DT10745-055	ADAPTER, BAYONET HOUSING	
1	DT10745-17	BRACKET	
1	DT10745-19	GUARD	
A/R	DP460	EPOXY	3M
5	MS21209C0615	HELICOIL	
2	MS21209F4-15	HELICOIL	

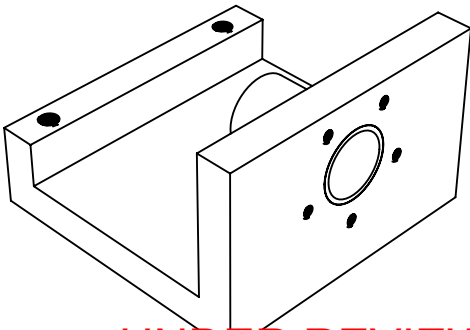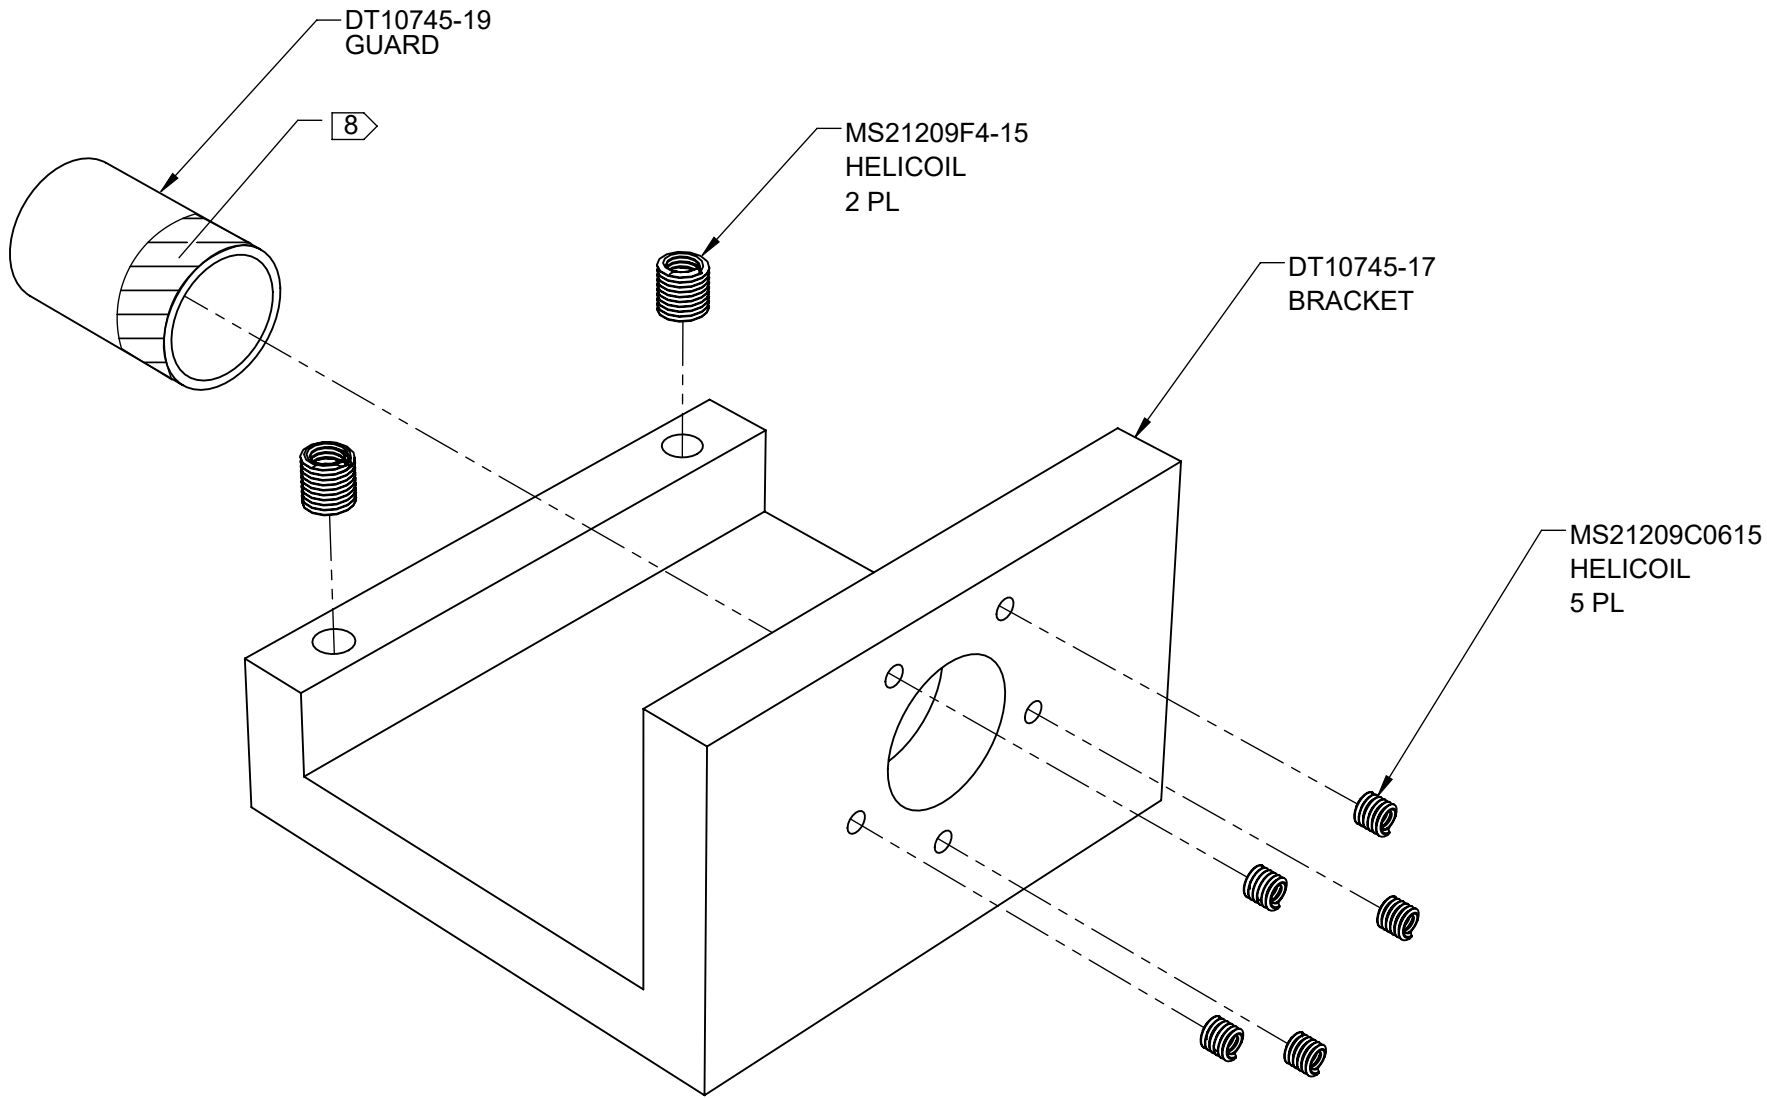



UNDER REVIEW
ECR: ECR 314
~~DT10745-055 ADAPTER, BAYONET HOUSING~~

NOTES:
1) MATERIAL: N/A
2) FINISH: N/A
3) TOLERANCES: PER DART QSI 018 UNLESS OTHERWISE NOTED
4) UNITS: INCHES UNLESS OTHERWISE NOTED
5) BREAK SHARP EDGES: N/A
6) IDENTIFICATION: IDENTIFY WITH DART P/N "DT10745-055" PER QSI 044 6.5
7) WEIGHT: 1.25 lbs
8) APPLY EPOXY TO AREA INDICATED. ENSURE GUARD IS PERPENDICULAR TO SURFACE WHILE EPOXY CURES

PRELIMINARY ISSUE

DESIGN	JC	DART AEROSPACE LTD HAWKESBURY, ONTARIO, CANADA
DRAWN	PP	
CHECKED		DRAWING NO. REV.
MFG. APPR.		DT10745 SHEET 4 OF 29
APPROVED		TITLE SCALE
DE APPR.		KIT, VALVE PULL TEST NTS
DATE	21.03.16	COPYRIGHT © 2021 BY DART AEROSPACE LTD <small>THIS DOCUMENT IS PRIVATE AND CONFIDENTIAL AND IS SUPPLIED ON THE EXPRESS CONDITION THAT IT IS NOT TO BE USED FOR ANY PURPOSE OR COPIED OR COMMUNICATED TO ANY OTHER PERSON WITHOUT WRITTEN PERMISSION FROM DART AEROSPACE LTD.</small>

QTY -057	P/N	DESCRIPTION	SUPPLIER
X	DT10745-057	RESERVOIR ADAPTER ASSEMBLY	
1	DT10745-15	ADAPTER, RESERVOIR	
1	MS28775-130	O-RING	
A/R	240AZ	O-RING LUBRICANT	KRYTOX
2	MS21209F4-15	HELICOIL	

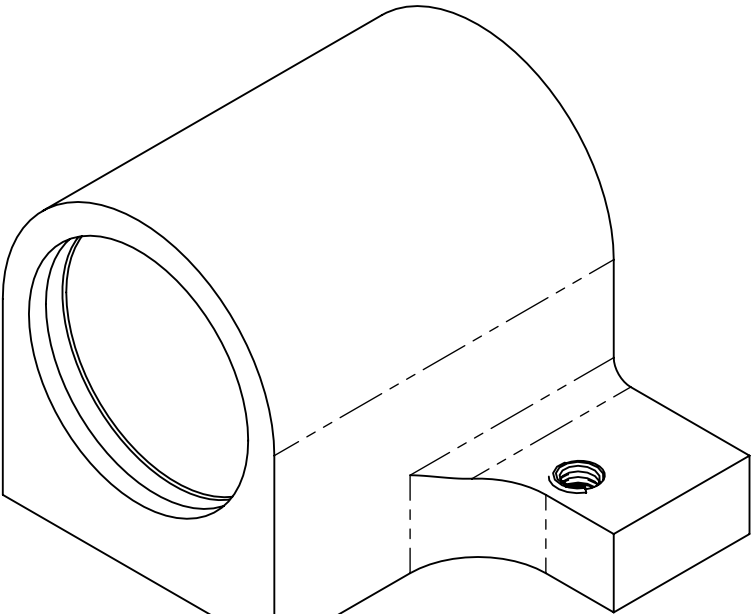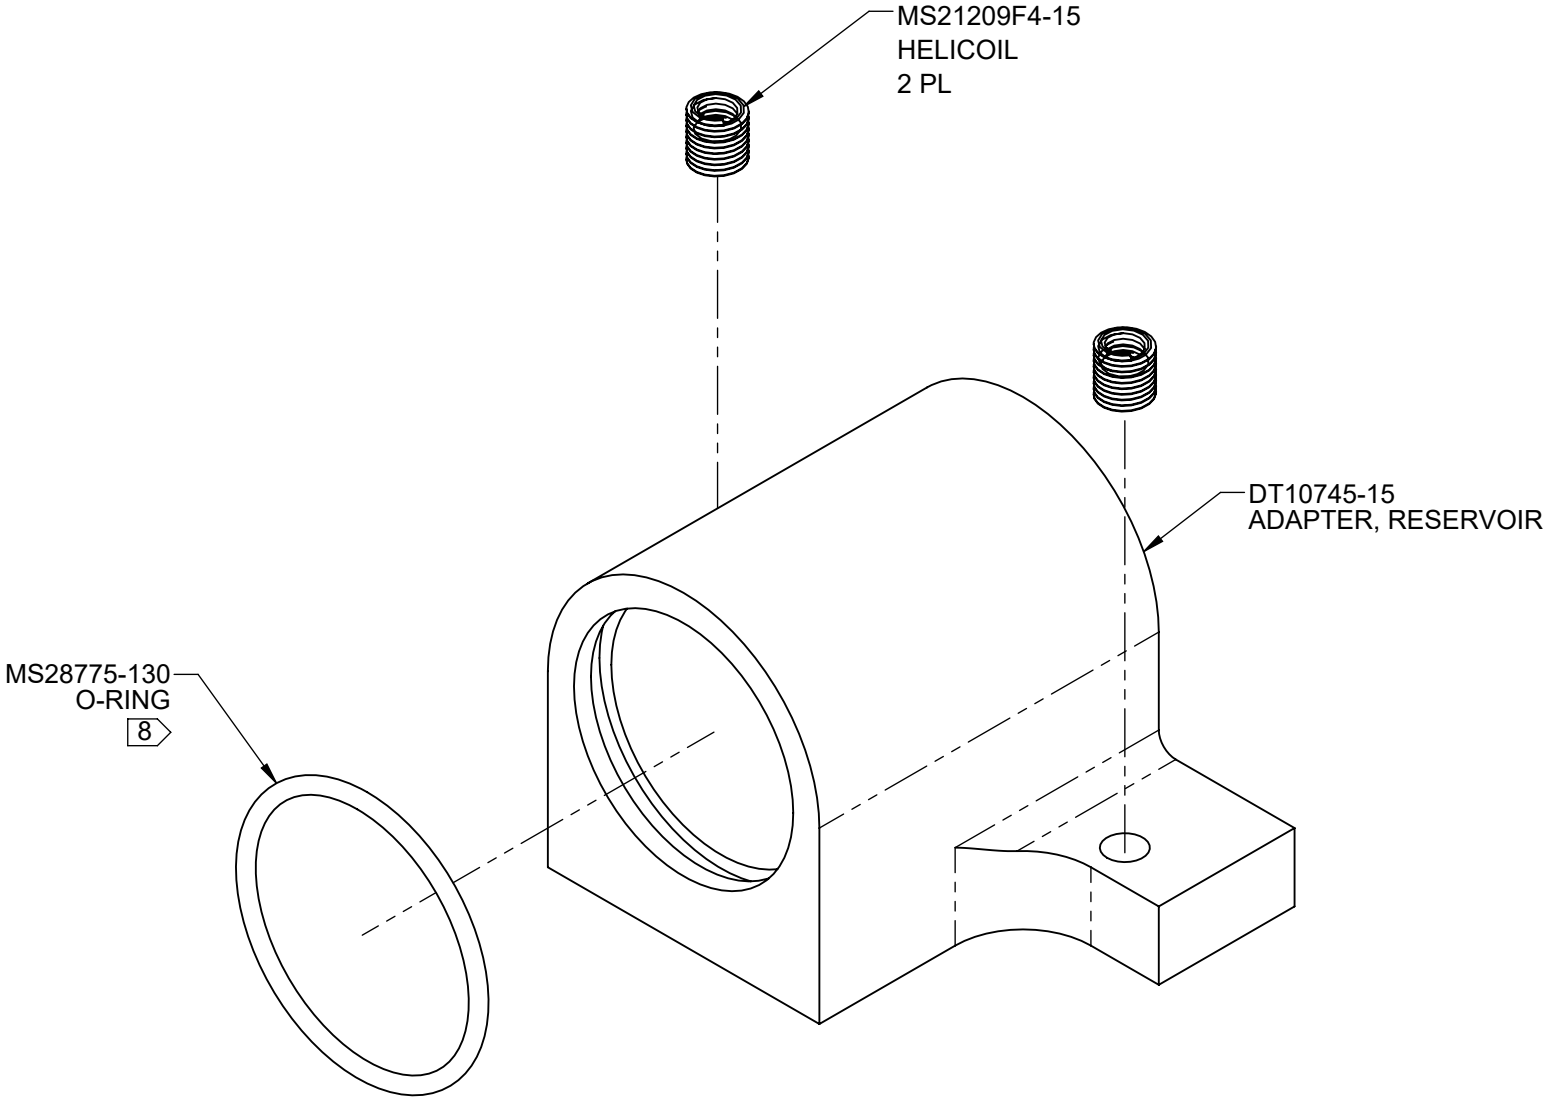

UNDER REVIEW

ECR: ECR 314


DT10745-057 RESERVOIR ADAPTER ASSEMBLY

NOTES:
1) MATERIAL: N/A
2) FINISH: N/A
3) TOLERANCES: PER DART QSI 018 UNLESS OTHERWISE NOTED
4) UNITS: INCHES UNLESS OTHERWISE NOTED
5) BREAK SHARP EDGES: N/A
6) IDENTIFICATION: IDENTIFY WITH DART P/N "DT10745-057" PER QSI 044 6.5
7) WEIGHT: 0.61 lbs
8) APPLY O-RING LUBRICANT TO ENTIRE SURFACE OF O-RING PRIOR TO INSTALLATION

PRELIMINARY ISSUE

DESIGN	JC	DART AEROSPACE LTD HAWKESBURY, ONTARIO, CANADA
DRAWN	PP	
CHECKED		DRAWING NO. REV.
MFG. APPR.		DT10745 SHEET 5 OF 29
APPROVED		TITLE SCALE
DE APPR.		KIT, VALVE PULL TEST NTS
DATE	21.03.16	COPYRIGHT © 2021 BY DART AEROSPACE LTD THIS DOCUMENT IS PRIVATE AND CONFIDENTIAL AND IS SUPPLIED ON THE EXPRESS CONDITION THAT IT IS NOT TO BE USED FOR ANY PURPOSE OR COPIED OR COMMUNICATED TO ANY OTHER PERSON WITHOUT WRITTEN PERMISSION FROM DART AEROSPACE LTD.

QTY -059	P/N	DESCRIPTION
X	DT10745-059	PACKAGING ASSEMBLY
1	1600	PELICAN CASE
1	DT10745-23	FOAM, BOTTOM
1	DT10745-25	FOAM, TOP

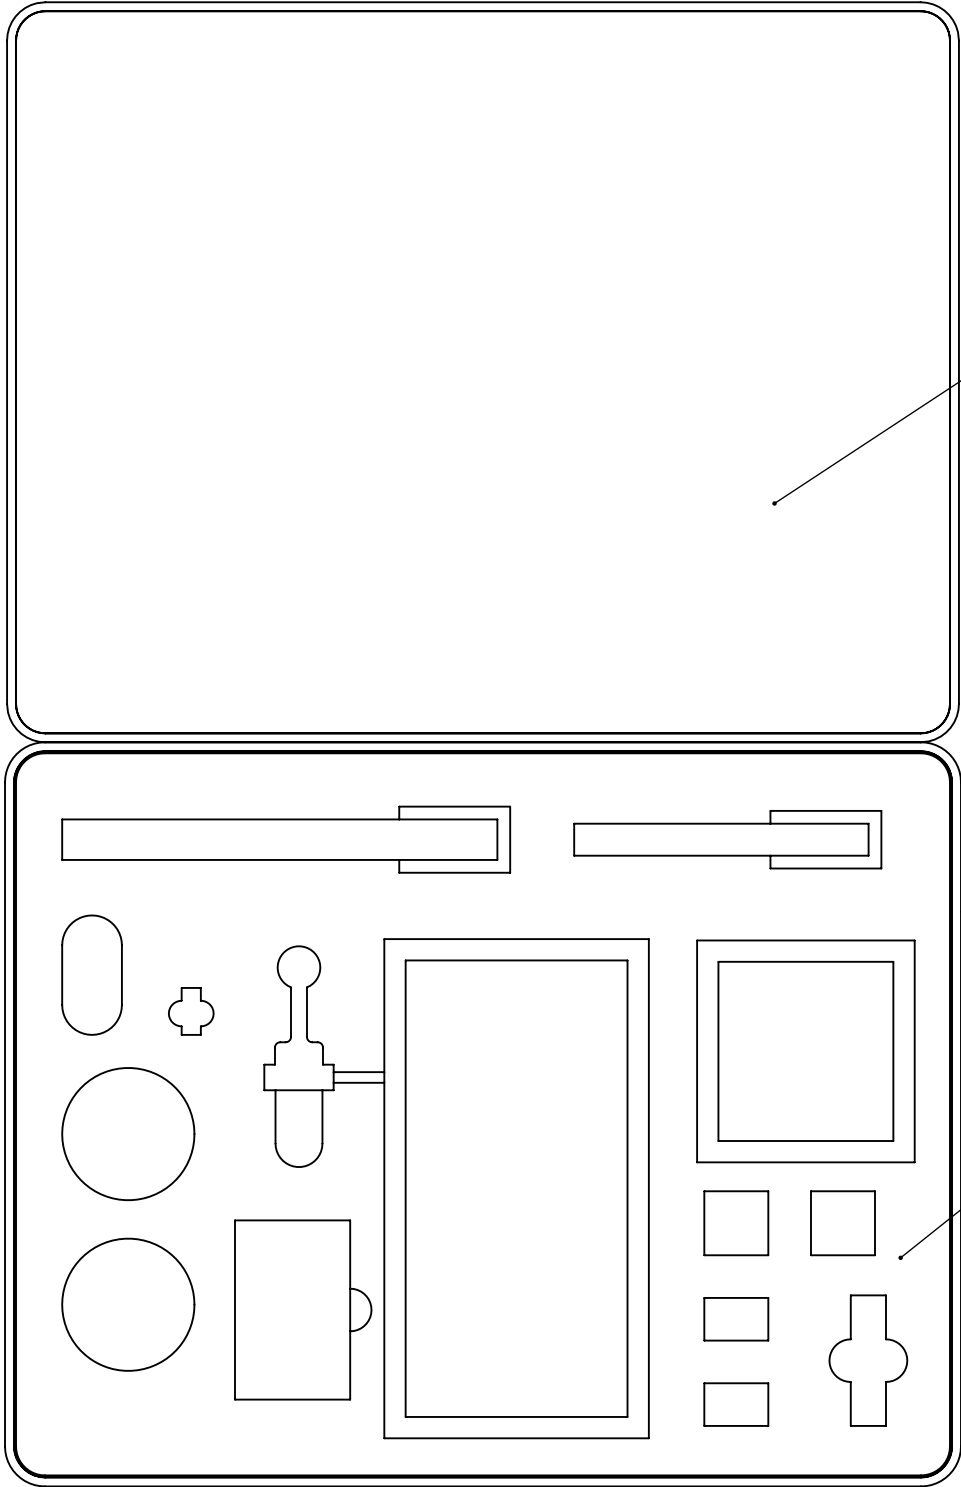

DT10745-059 PACKAGING ASSEMBLY

NOTES:
1) MATERIAL: N/A
2) FINISH: N/A
3) TOLERANCES: PER DART QSI 018 UNLESS OTHERWISE NOTED
4) UNITS: INCHES UNLESS OTHERWISE NOTED
5) BREAK SHARP EDGES: N/A
6) IDENTIFICATION: IDENTIFY WITH DART P/N "DT10745-059" PER QSI 044 6.5
7) WEIGHT: N/A

PRELIMINARY ISSUE


UNDER REVIEW
ECR: ECR 314

DESIGN	JC	DART AEROSPACE LTD HAWKESBURY, ONTARIO, CANADA
DRAWN	PP	
CHECKED		DRAWING NO. REV.
MFG. APPR.		DT10745 SHEET 6 OF 29
APPROVED		TITLE SCALE
DE APPR.		KIT, VALVE PULL TEST NTS
DATE	21.03.16	COPYRIGHT © 2021 BY DART AEROSPACE LTD <small>THIS DOCUMENT IS PRIVATE AND CONFIDENTIAL AND IS SUPPLIED ON THE EXPRESS CONDITION THAT IT IS NOT TO BE USED FOR ANY PURPOSE OR COPIED OR COMMUNICATED TO ANY OTHER PERSON WITHOUT WRITTEN PERMISSION FROM DART AEROSPACE LTD.</small>

QTY -061	P/N	DESCRIPTION
X	DT10745-061	PLATE ASSEMBLY
1	DT10745-29	PLATE
2	MS21209F4-15	HELICOIL

MS21209F4-15
HELICOIL
2 PL

DT10745-29
PLATE

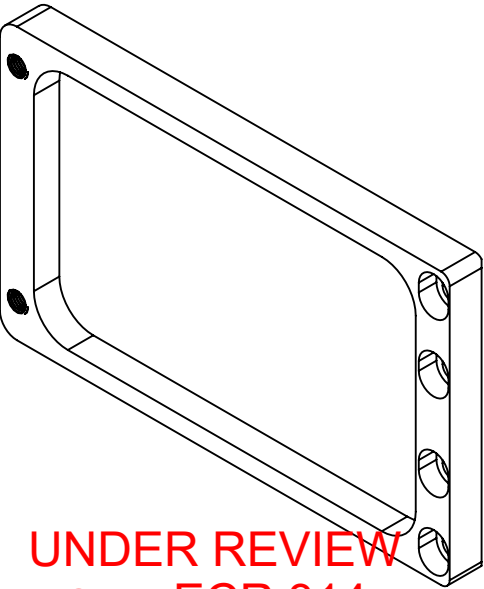



UNDER REVIEW
ECR: ECR 314
DT10745-061 PLATE ASSEMBLY

NOTES:
1) MATERIAL: N/A
2) FINISH: N/A
3) TOLERANCES: PER DART QSI 018 UNLESS OTHERWISE NOTED
4) UNITS: INCHES UNLESS OTHERWISE NOTED
5) BREAK SHARP EDGES: N/A
6) IDENTIFICATION: IDENTIFY WITH DART P/N "DT10745-061" PER QSI 044 6.5
7) WEIGHT: N/A

PRELIMINARY ISSUE

DESIGN	JC	DART AEROSPACE LTD HAWKESBURY, ONTARIO, CANADA
DRAWN	PP	
CHECKED		DRAWING NO. REV.
MFG. APPR.		DT10745 SHEET 7 OF 29
APPROVED		TITLE SCALE
DE APPR.		KIT, VALVE PULL TEST NTS
DATE	21.03.16	COPYRIGHT © 2021 BY DART AEROSPACE LTD THIS DOCUMENT IS PRIVATE AND CONFIDENTIAL AND IS SUPPLIED ON THE EXPRESS CONDITION THAT IT IS NOT TO BE USED FOR ANY PURPOSE OR COPIED OR COMMUNICATED TO ANY OTHER PERSON WITHOUT WRITTEN PERMISSION FROM DART AEROSPACE LTD.

QTY -063	P/N	DESCRIPTION
X	DT10745-063	PLATE ASSEMBLY
1	DT10745-31	PLATE
2	MS21209F4-15	HELICOIL

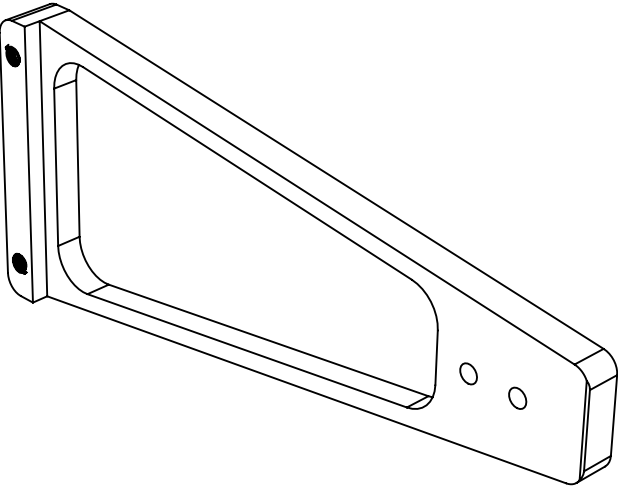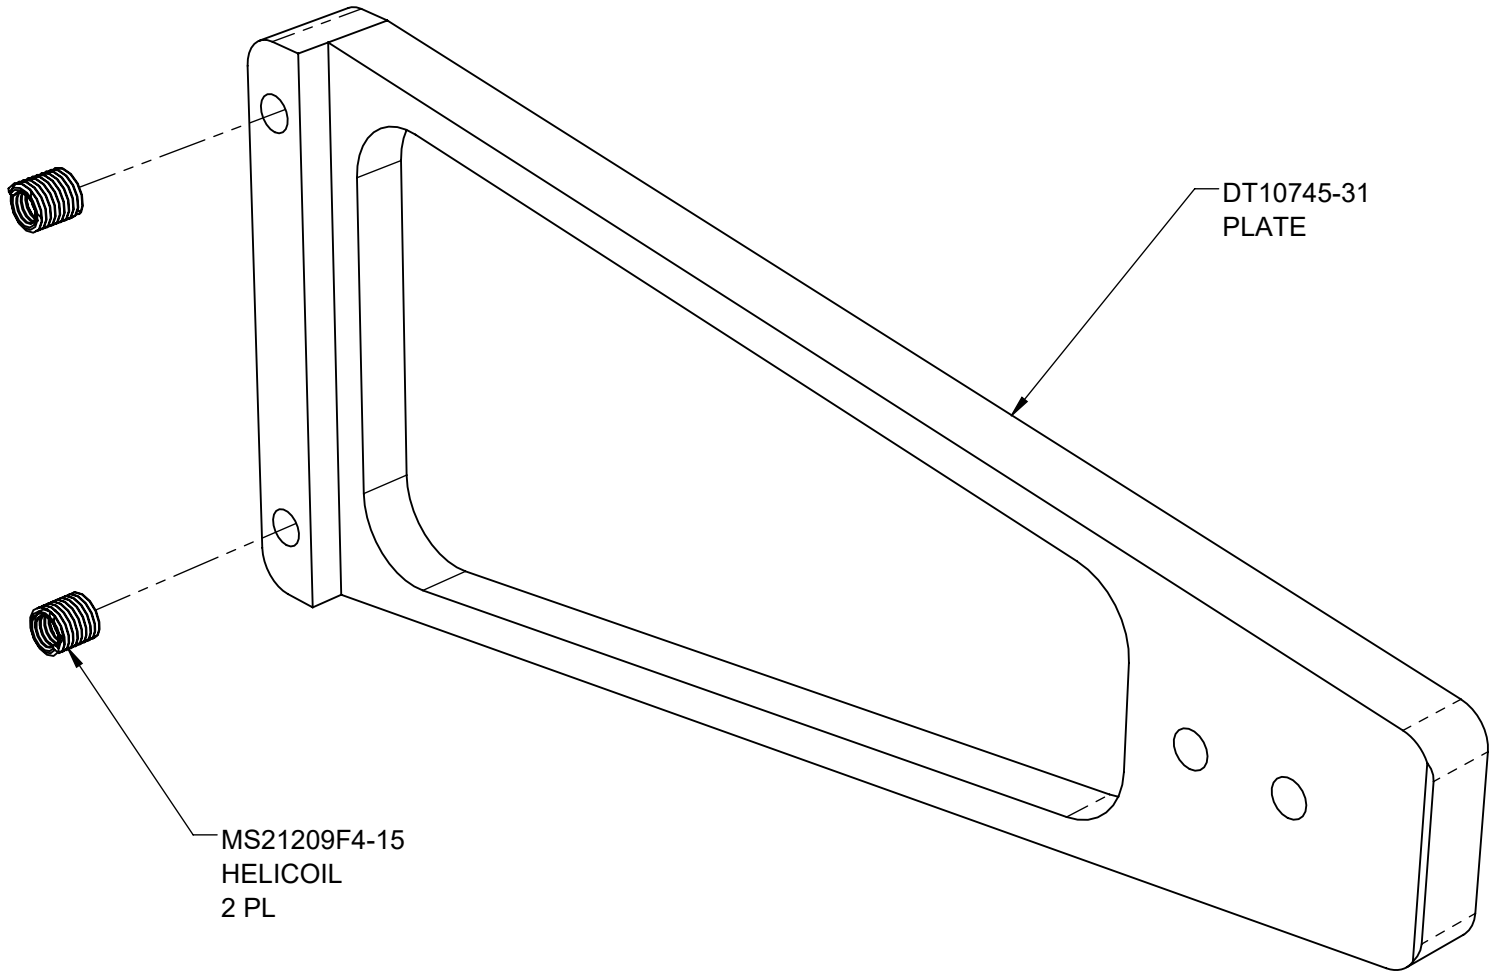



UNDER REVIEW
~~DT10745-063 PLATE ASSEMBLY~~
ECR. ECR 314

- NOTES:
- 1) MATERIAL: N/A
 - 2) FINISH: N/A
 - 3) TOLERANCES: PER DART QSI 018 UNLESS OTHERWISE NOTED
 - 4) UNITS: INCHES UNLESS OTHERWISE NOTED
 - 5) BREAK SHARP EDGES: N/A
 - 6) IDENTIFICATION: IDENTIFY WITH DART P/N "DT10745-063" PER QSI 044 6.5
 - 7) WEIGHT: N/A

PRELIMINARY ISSUE

DESIGN	JC	DART AEROSPACE LTD HAWKESBURY, ONTARIO, CANADA
DRAWN	PP	
CHECKED		DRAWING NO. REV.
MFG. APPR.		DT10745 SHEET 8 OF 29
APPROVED		TITLE SCALE
DE APPR.		KIT, VALVE PULL TEST NTS
DATE	21.03.16	COPYRIGHT © 2021 BY DART AEROSPACE LTD <small>THIS DOCUMENT IS PRIVATE AND CONFIDENTIAL AND IS SUPPLIED ON THE EXPRESS CONDITION THAT IT IS NOT TO BE USED FOR ANY PURPOSE OR COPIED OR COMMUNICATED TO ANY OTHER PERSON WITHOUT WRITTEN PERMISSION FROM DART AEROSPACE LTD.</small>

QTY -065	P/N	DESCRIPTION
X	DT10745-065	ADAPTER, BAYONET HOUSING
1	DT10745-33	BAYONET HOUSING ADAPTER
4	MS21209F4-15	HELICOIL
4	MS21209C0815	HELICOIL

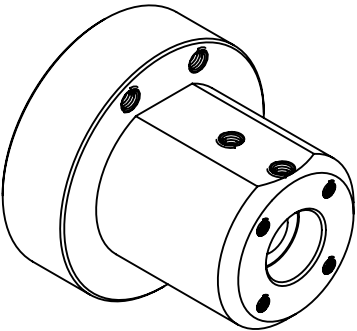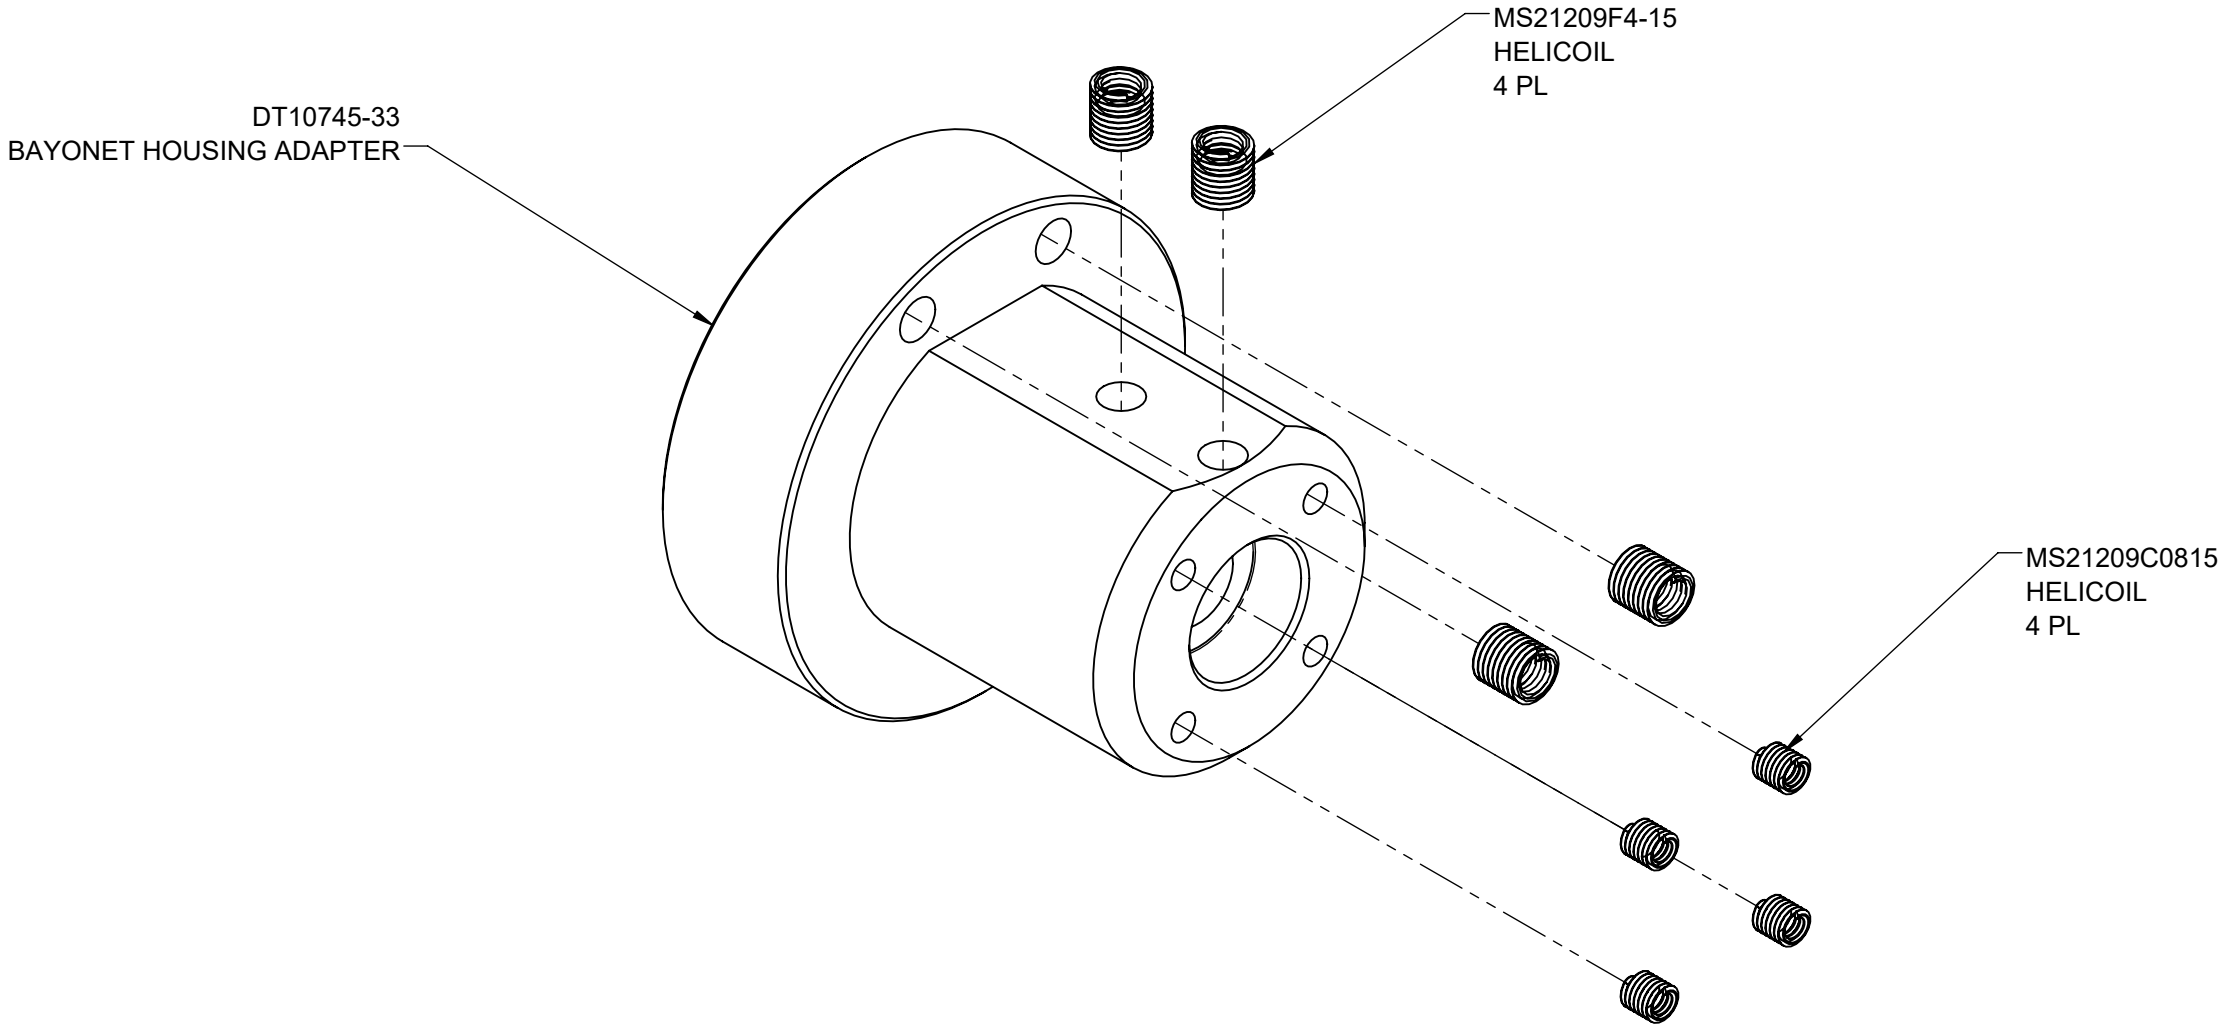

UNDER REVIEW
FOR FCR 314
DT10745-065 ADAPTER, BAYONET HOUSING

NOTES:
1) MATERIAL: N/A
2) FINISH: N/A
3) TOLERANCES: PER DART QSI 018 UNLESS OTHERWISE NOTED
4) UNITS: INCHES UNLESS OTHERWISE NOTED
5) BREAK SHARP EDGES: N/A
6) IDENTIFICATION: IDENTIFY WITH DART P/N "DT10745-065" PER QSI 044 6.5
7) WEIGHT: N/A

PRELIMINARY ISSUE

DESIGN	JC	DART AEROSPACE LTD HAWKESBURY, ONTARIO, CANADA
DRAWN	PP	
CHECKED		DRAWING NO. REV.
MFG. APPR.		DT10745 SHEET 9 OF 29
APPROVED		TITLE SCALE
DE APPR.		KIT, VALVE PULL TEST NTS
DATE	21.03.16	COPYRIGHT © 2021 BY DART AEROSPACE LTD THIS DOCUMENT IS PRIVATE AND CONFIDENTIAL AND IS SUPPLIED ON THE EXPRESS CONDITION THAT IT IS NOT TO BE USED FOR ANY PURPOSE OR COPIED OR COMMUNICATED TO ANY OTHER PERSON WITHOUT WRITTEN PERMISSION FROM DART AEROSPACE LTD.

QTY -067	P/N	DESCRIPTION
X	DT10745-067	ADAPTER, BAYONET HOUSING
1	DT10745-35	BAYONET HOUSING ADAPTER
2	MS21209F4-15	HELICOIL
4	MS21209C0815	HELICOIL


D

C

B


A

DT10745-35
BAYONET HOUSING ADAPTER

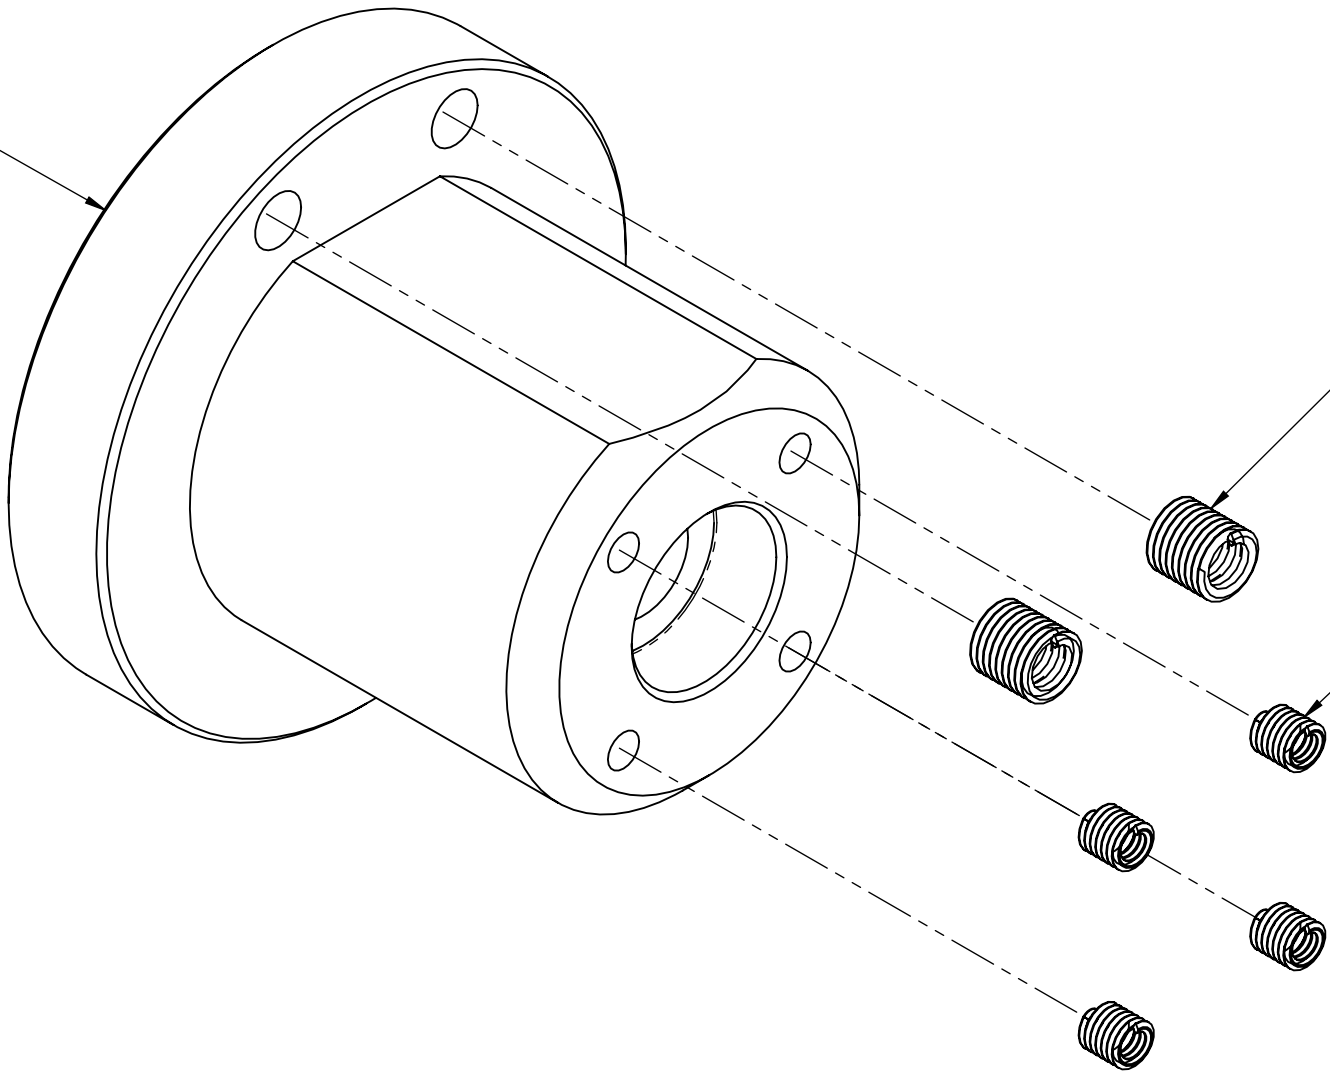

MS21209F4-15
HELICOIL
2 PL

MS21209C0815
HELICOIL
4 PL

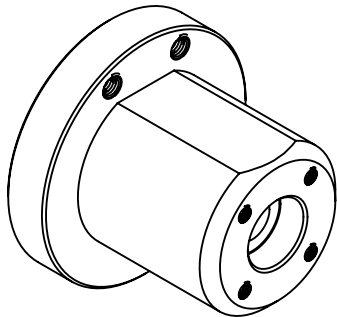

UNDER REVIEW

~~DT10745-067 ADAPTER, BAYONET HOUSING~~
~~FOR ECR 314~~

NOTES:
1) MATERIAL: N/A
2) FINISH: N/A
3) TOLERANCES: PER DART QSI 018 UNLESS OTHERWISE NOTED
4) UNITS: INCHES UNLESS OTHERWISE NOTED
5) BREAK SHARP EDGES: N/A
6) IDENTIFICATION: IDENTIFY WITH DART P/N "DT10745-067" PER QSI 044 6.5
7) WEIGHT: N/A

PRELIMINARY ISSUE


DESIGN	JC	DART AEROSPACE LTD HAWKESBURY, ONTARIO, CANADA
DRAWN	PP	
CHECKED		DRAWING NO. REV.
MFG. APPR.		DT10745 SHEET 10 OF 29
APPROVED		TITLE SCALE
DE APPR.		KIT, VALVE PULL TEST NTS
DATE	21.03.16	COPYRIGHT © 2021 BY DART AEROSPACE LTD <small>THIS DOCUMENT IS PRIVATE AND CONFIDENTIAL AND IS SUPPLIED ON THE EXPRESS CONDITION THAT IT IS NOT TO BE USED FOR ANY PURPOSE OR COPIED OR COMMUNICATED TO ANY OTHER PERSON WITHOUT WRITTEN PERMISSION FROM DART AEROSPACE LTD.</small>

D

C

B


A

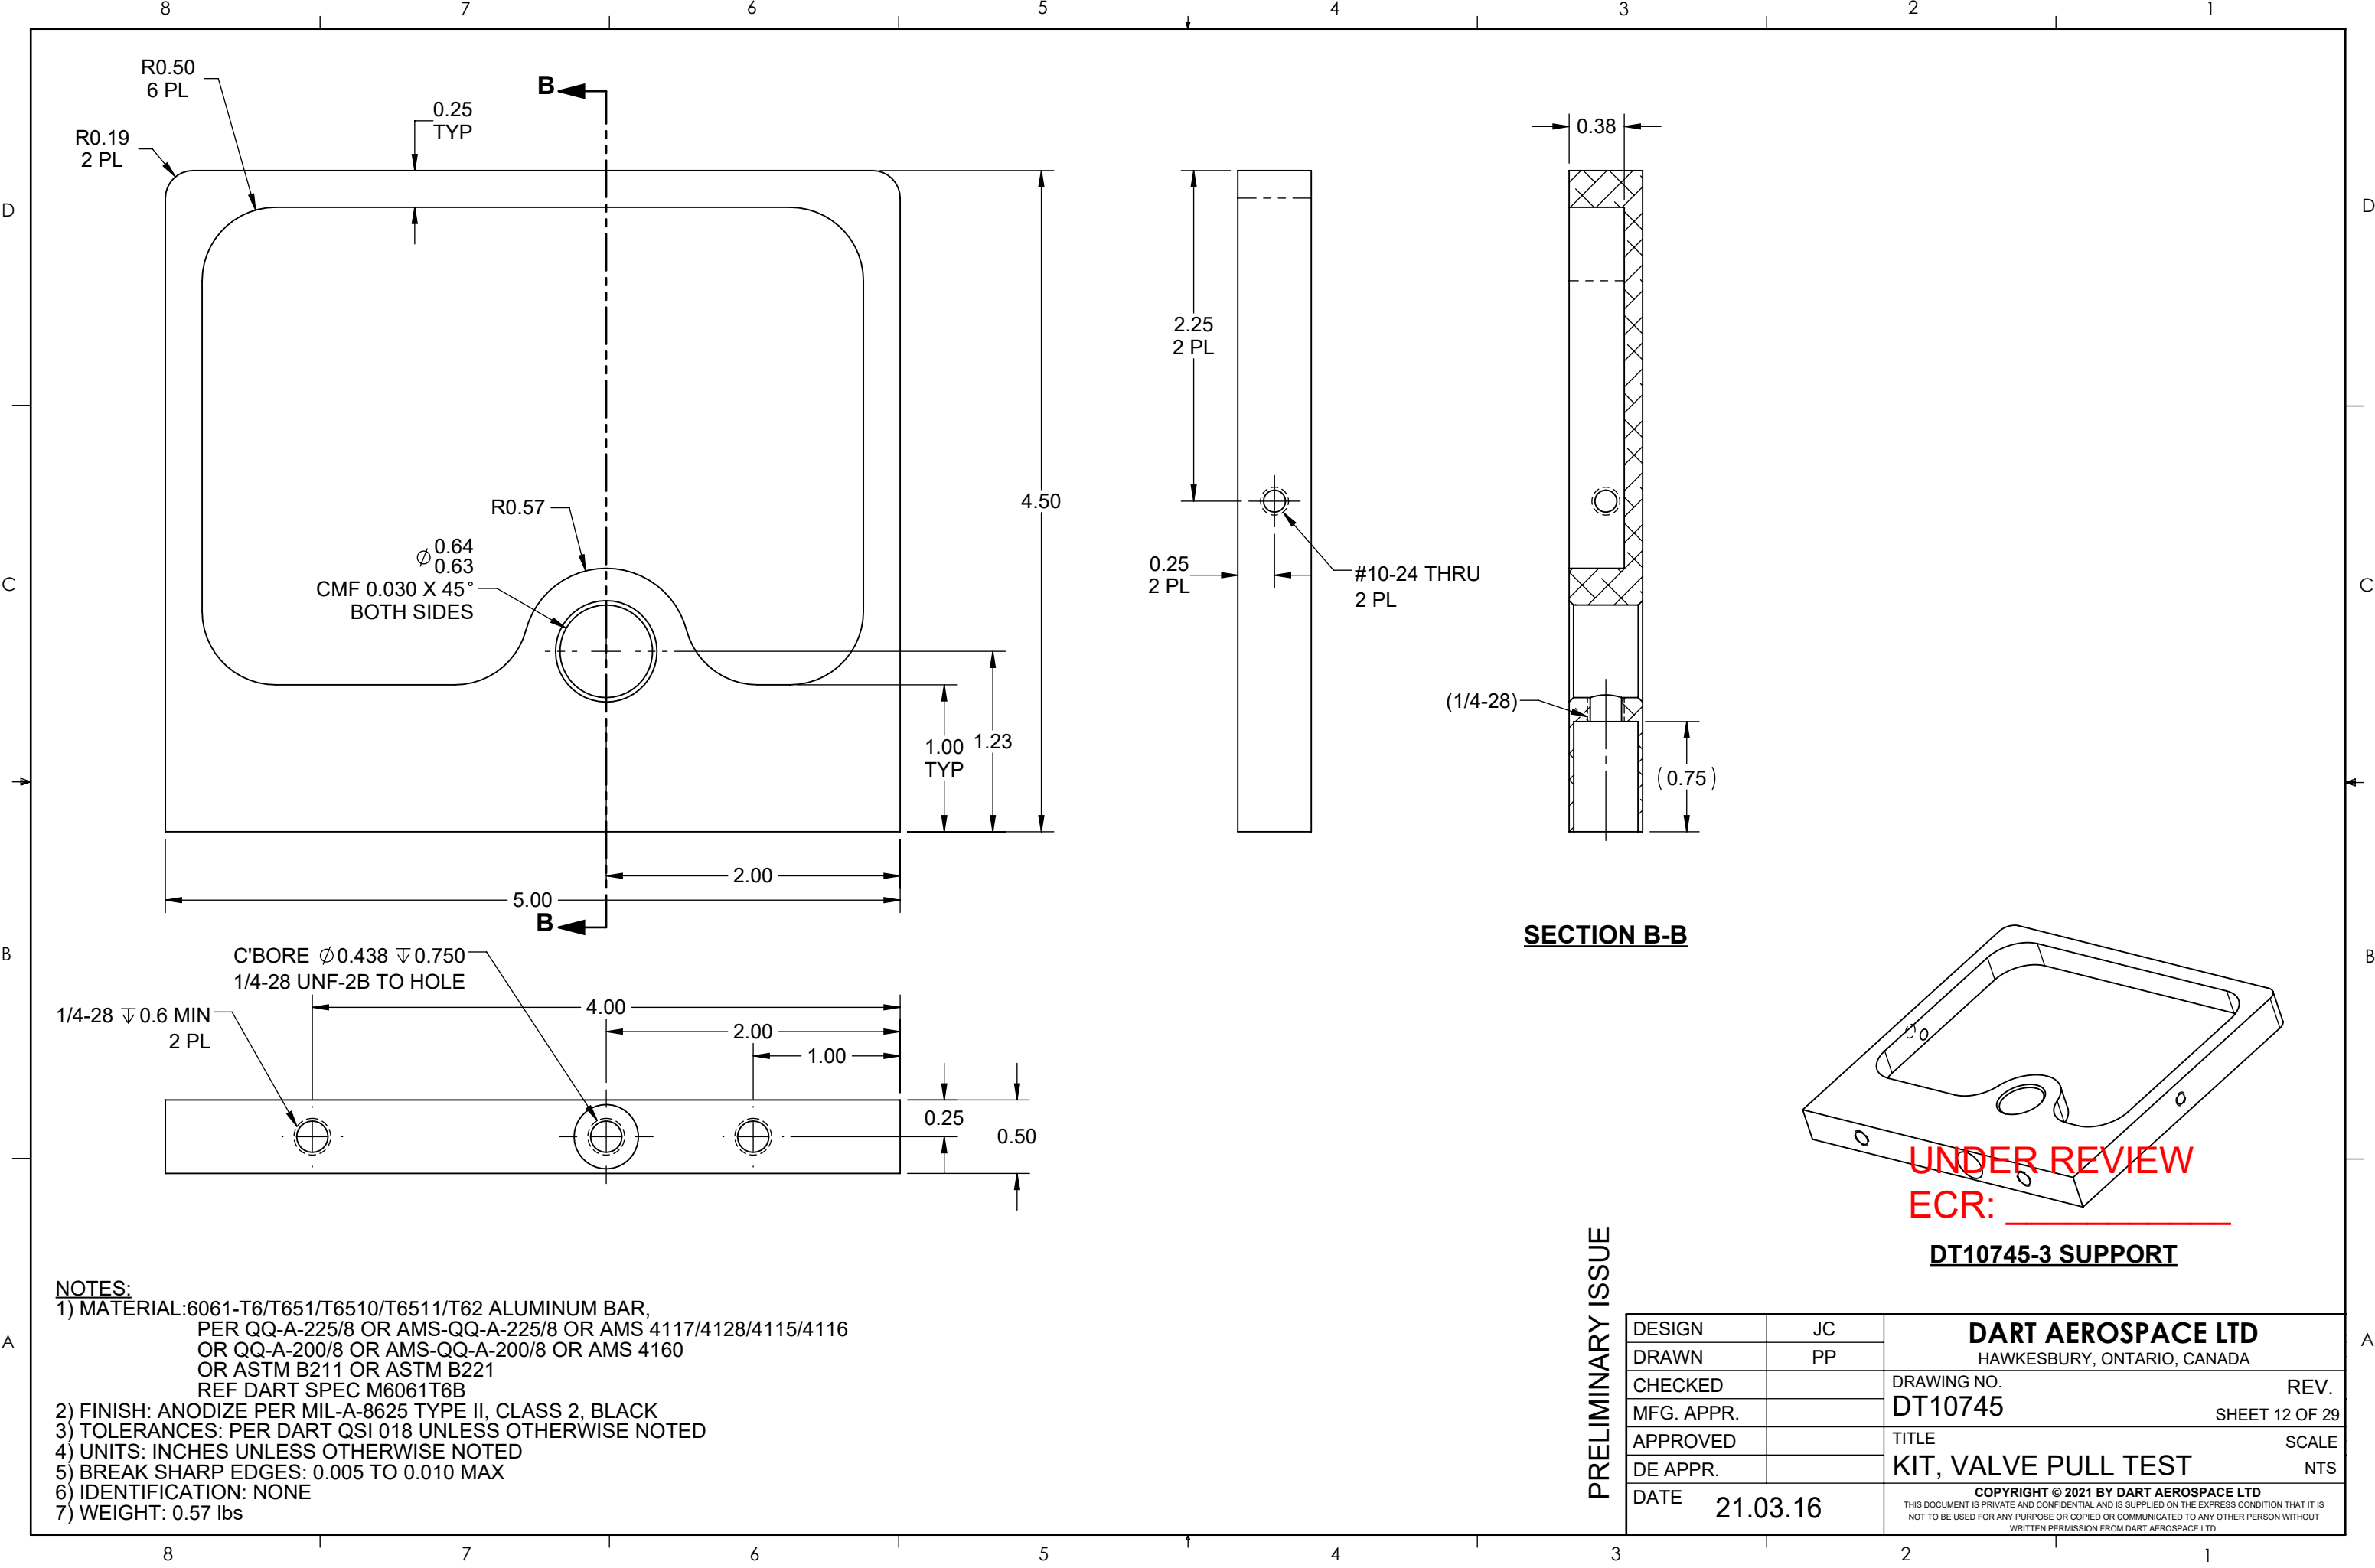

NOTES:
1) MATERIAL: 6061-T6/T651/T6510/T6511/T62 ALUMINUM BAR,
PER QQ-A-225/8 OR AMS-QQ-A-225/8 OR AMS 4117/4128/4115/4116
OR QQ-A-200/8 OR AMS-QQ-A-200/8 OR AMS 4160
OR ASTM B211 OR ASTM B221
REF DART SPEC M6061T6B
2) FINISH: ANODIZE PER MIL-A-8625 TYPE II, CLASS 2, BLACK
3) TOLERANCES: PER DART QSI 018 UNLESS OTHERWISE NOTED
4) UNITS: INCHES UNLESS OTHERWISE NOTED
5) BREAK SHARP EDGES: 0.005 TO 0.010 MAX
6) IDENTIFICATION: NONE
7) WEIGHT: 0.57 lbs

PRELIMINARY ISSUE

DESIGN	JC	DART AEROSPACE LTD HAWKESBURY, ONTARIO, CANADA	
DRAWN	PP		
CHECKED		DRAWING NO. DT10745	REV. SHEET 12 OF 29
MFG. APPR.		TITLE KIT, VALVE PULL TEST	
APPROVED			
DE APPR.		SCALE NTS	
DATE	21.03.16	COPYRIGHT © 2021 BY DART AEROSPACE LTD THIS DOCUMENT IS PRIVATE AND CONFIDENTIAL AND IS SUPPLIED ON THE EXPRESS CONDITION THAT IT IS NOT TO BE USED FOR ANY PURPOSE OR COPIED OR COMMUNICATED TO ANY OTHER PERSON WITHOUT WRITTEN PERMISSION FROM DART AEROSPACE LTD.	

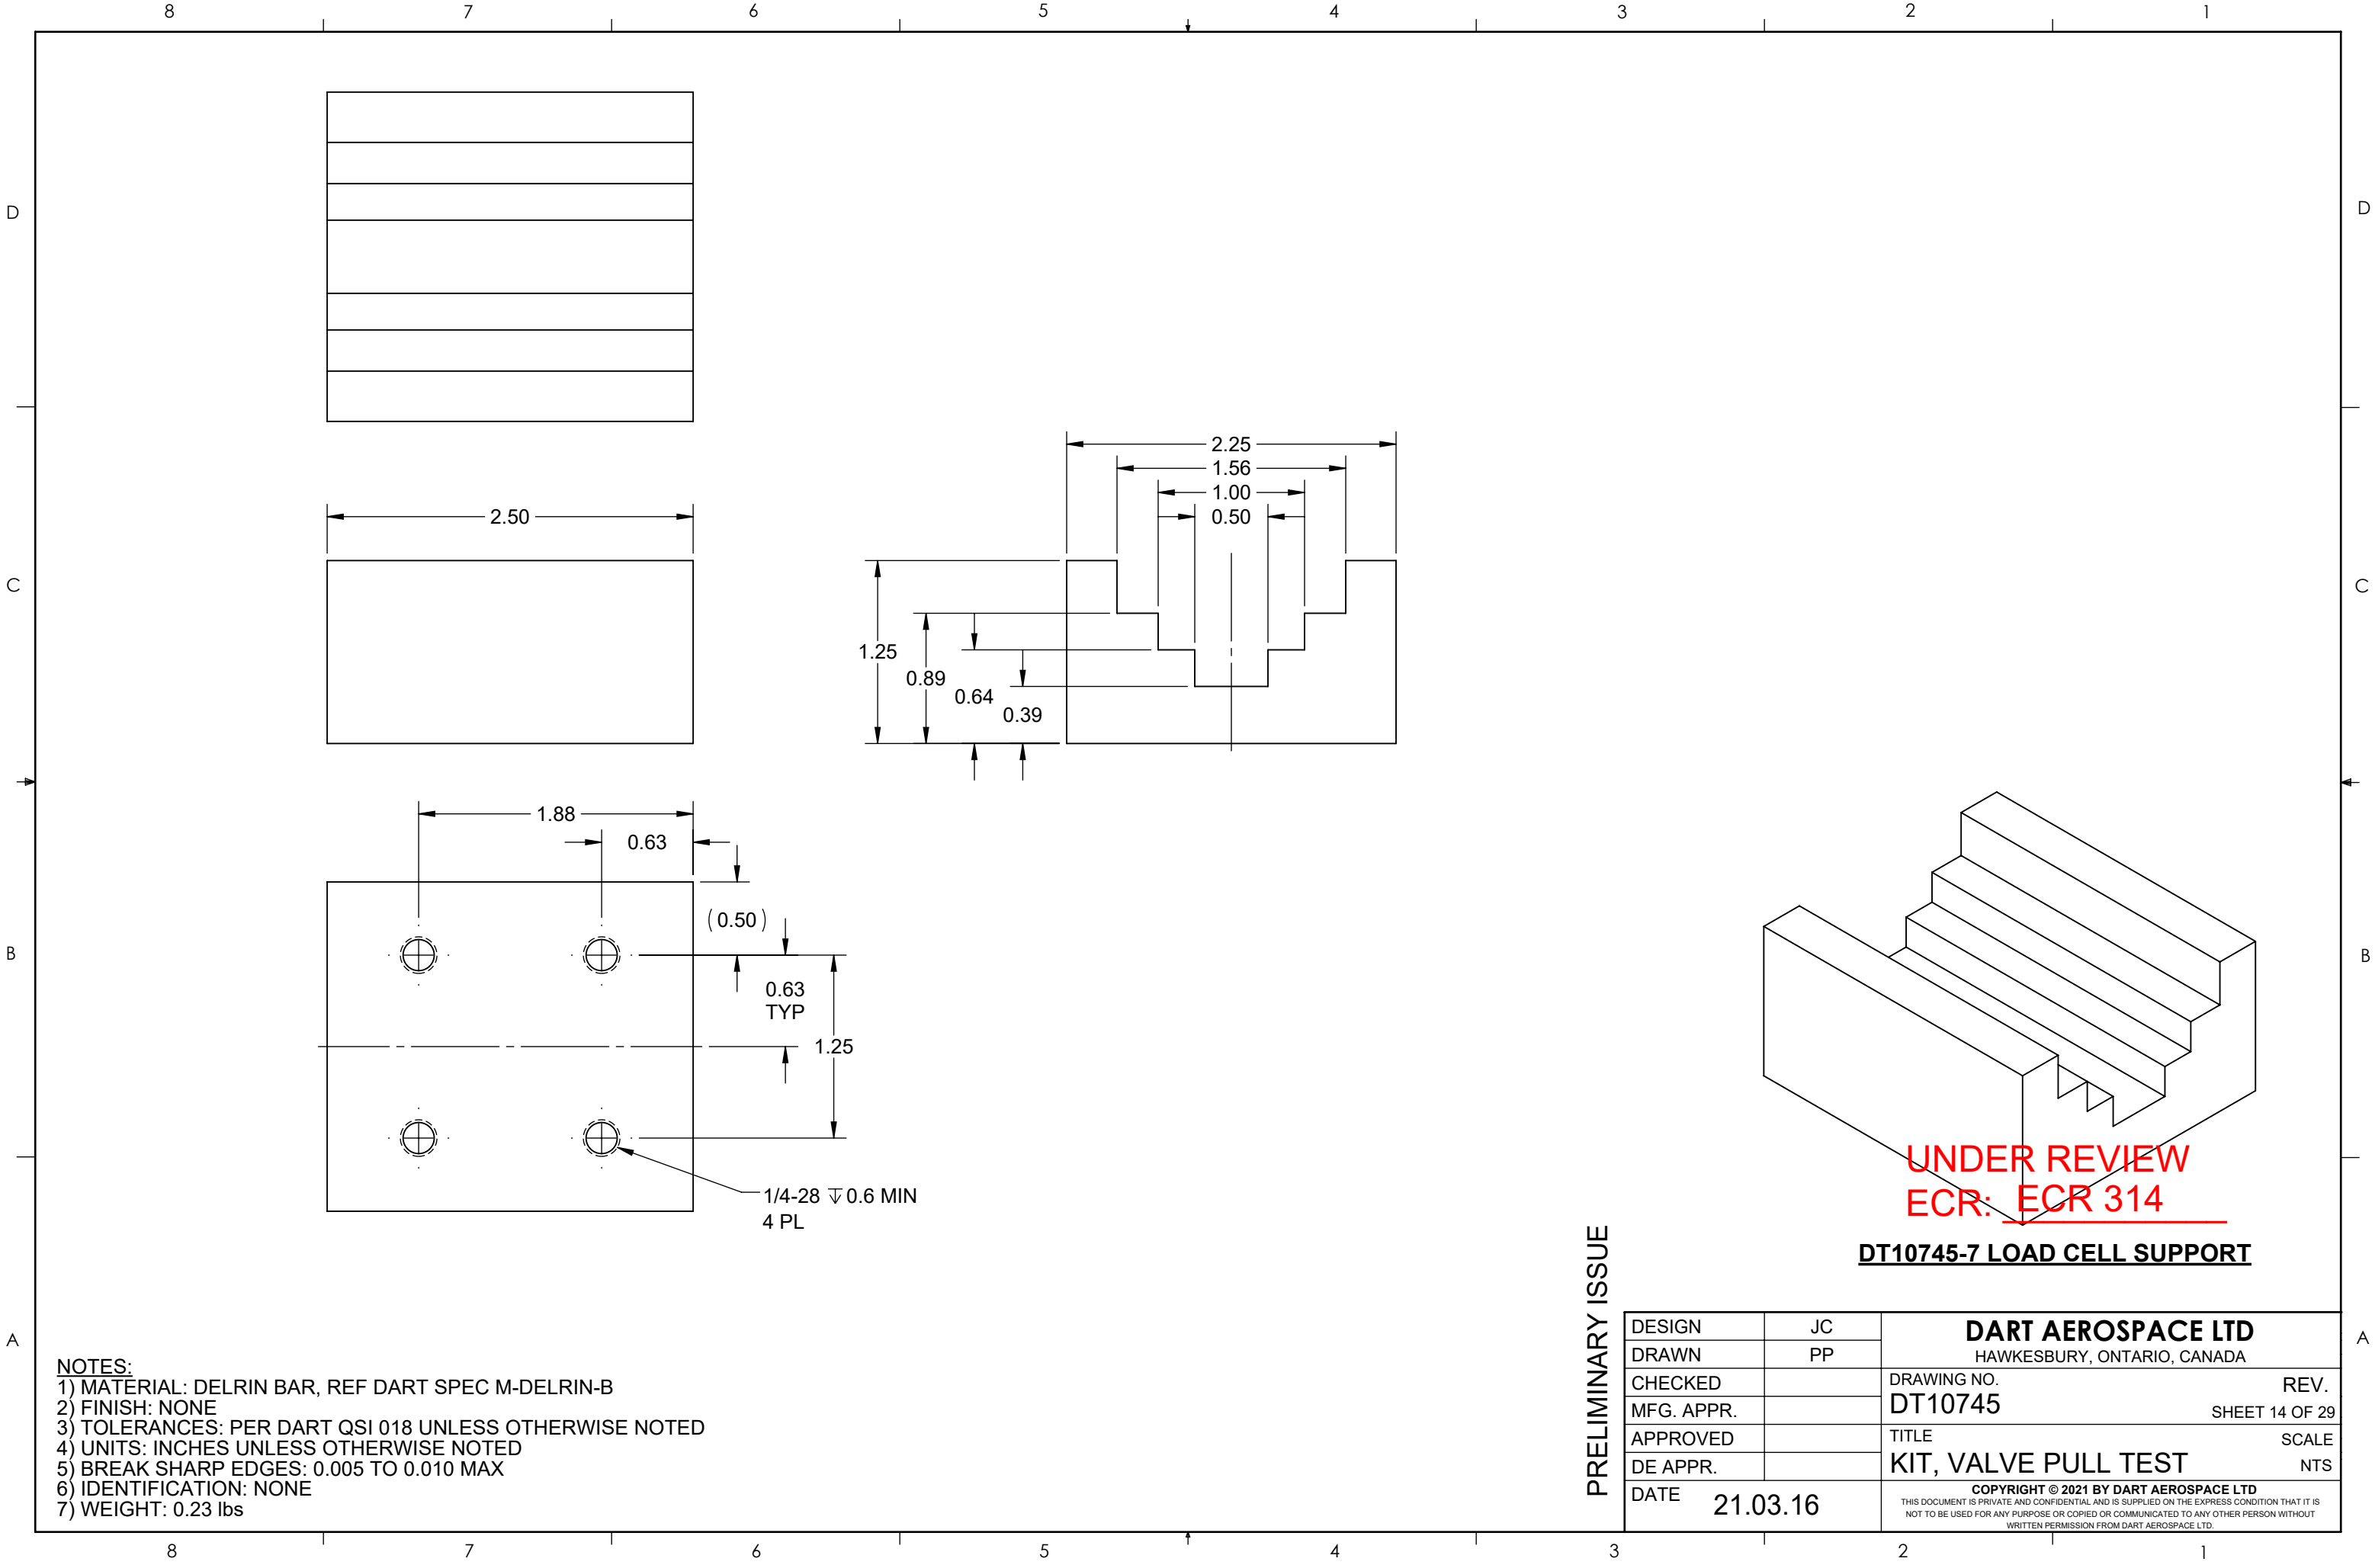


NOTES:
1) MATERIAL: DELRIN BAR, REF DART SPEC M-DELRIN-B
2) FINISH: NONE
3) TOLERANCES: PER DART QSI 018 UNLESS OTHERWISE NOTED
4) UNITS: INCHES UNLESS OTHERWISE NOTED
5) BREAK SHARP EDGES: 0.005 TO 0.010 MAX
6) IDENTIFICATION: NONE
7) WEIGHT: 0.23 lbs

1/4-28 ∇ 0.6 MIN
4 PL


UNDER REVIEW
ECR: ECR 314
DT10745-7 LOAD CELL SUPPORT

PRELIMINARY ISSUE

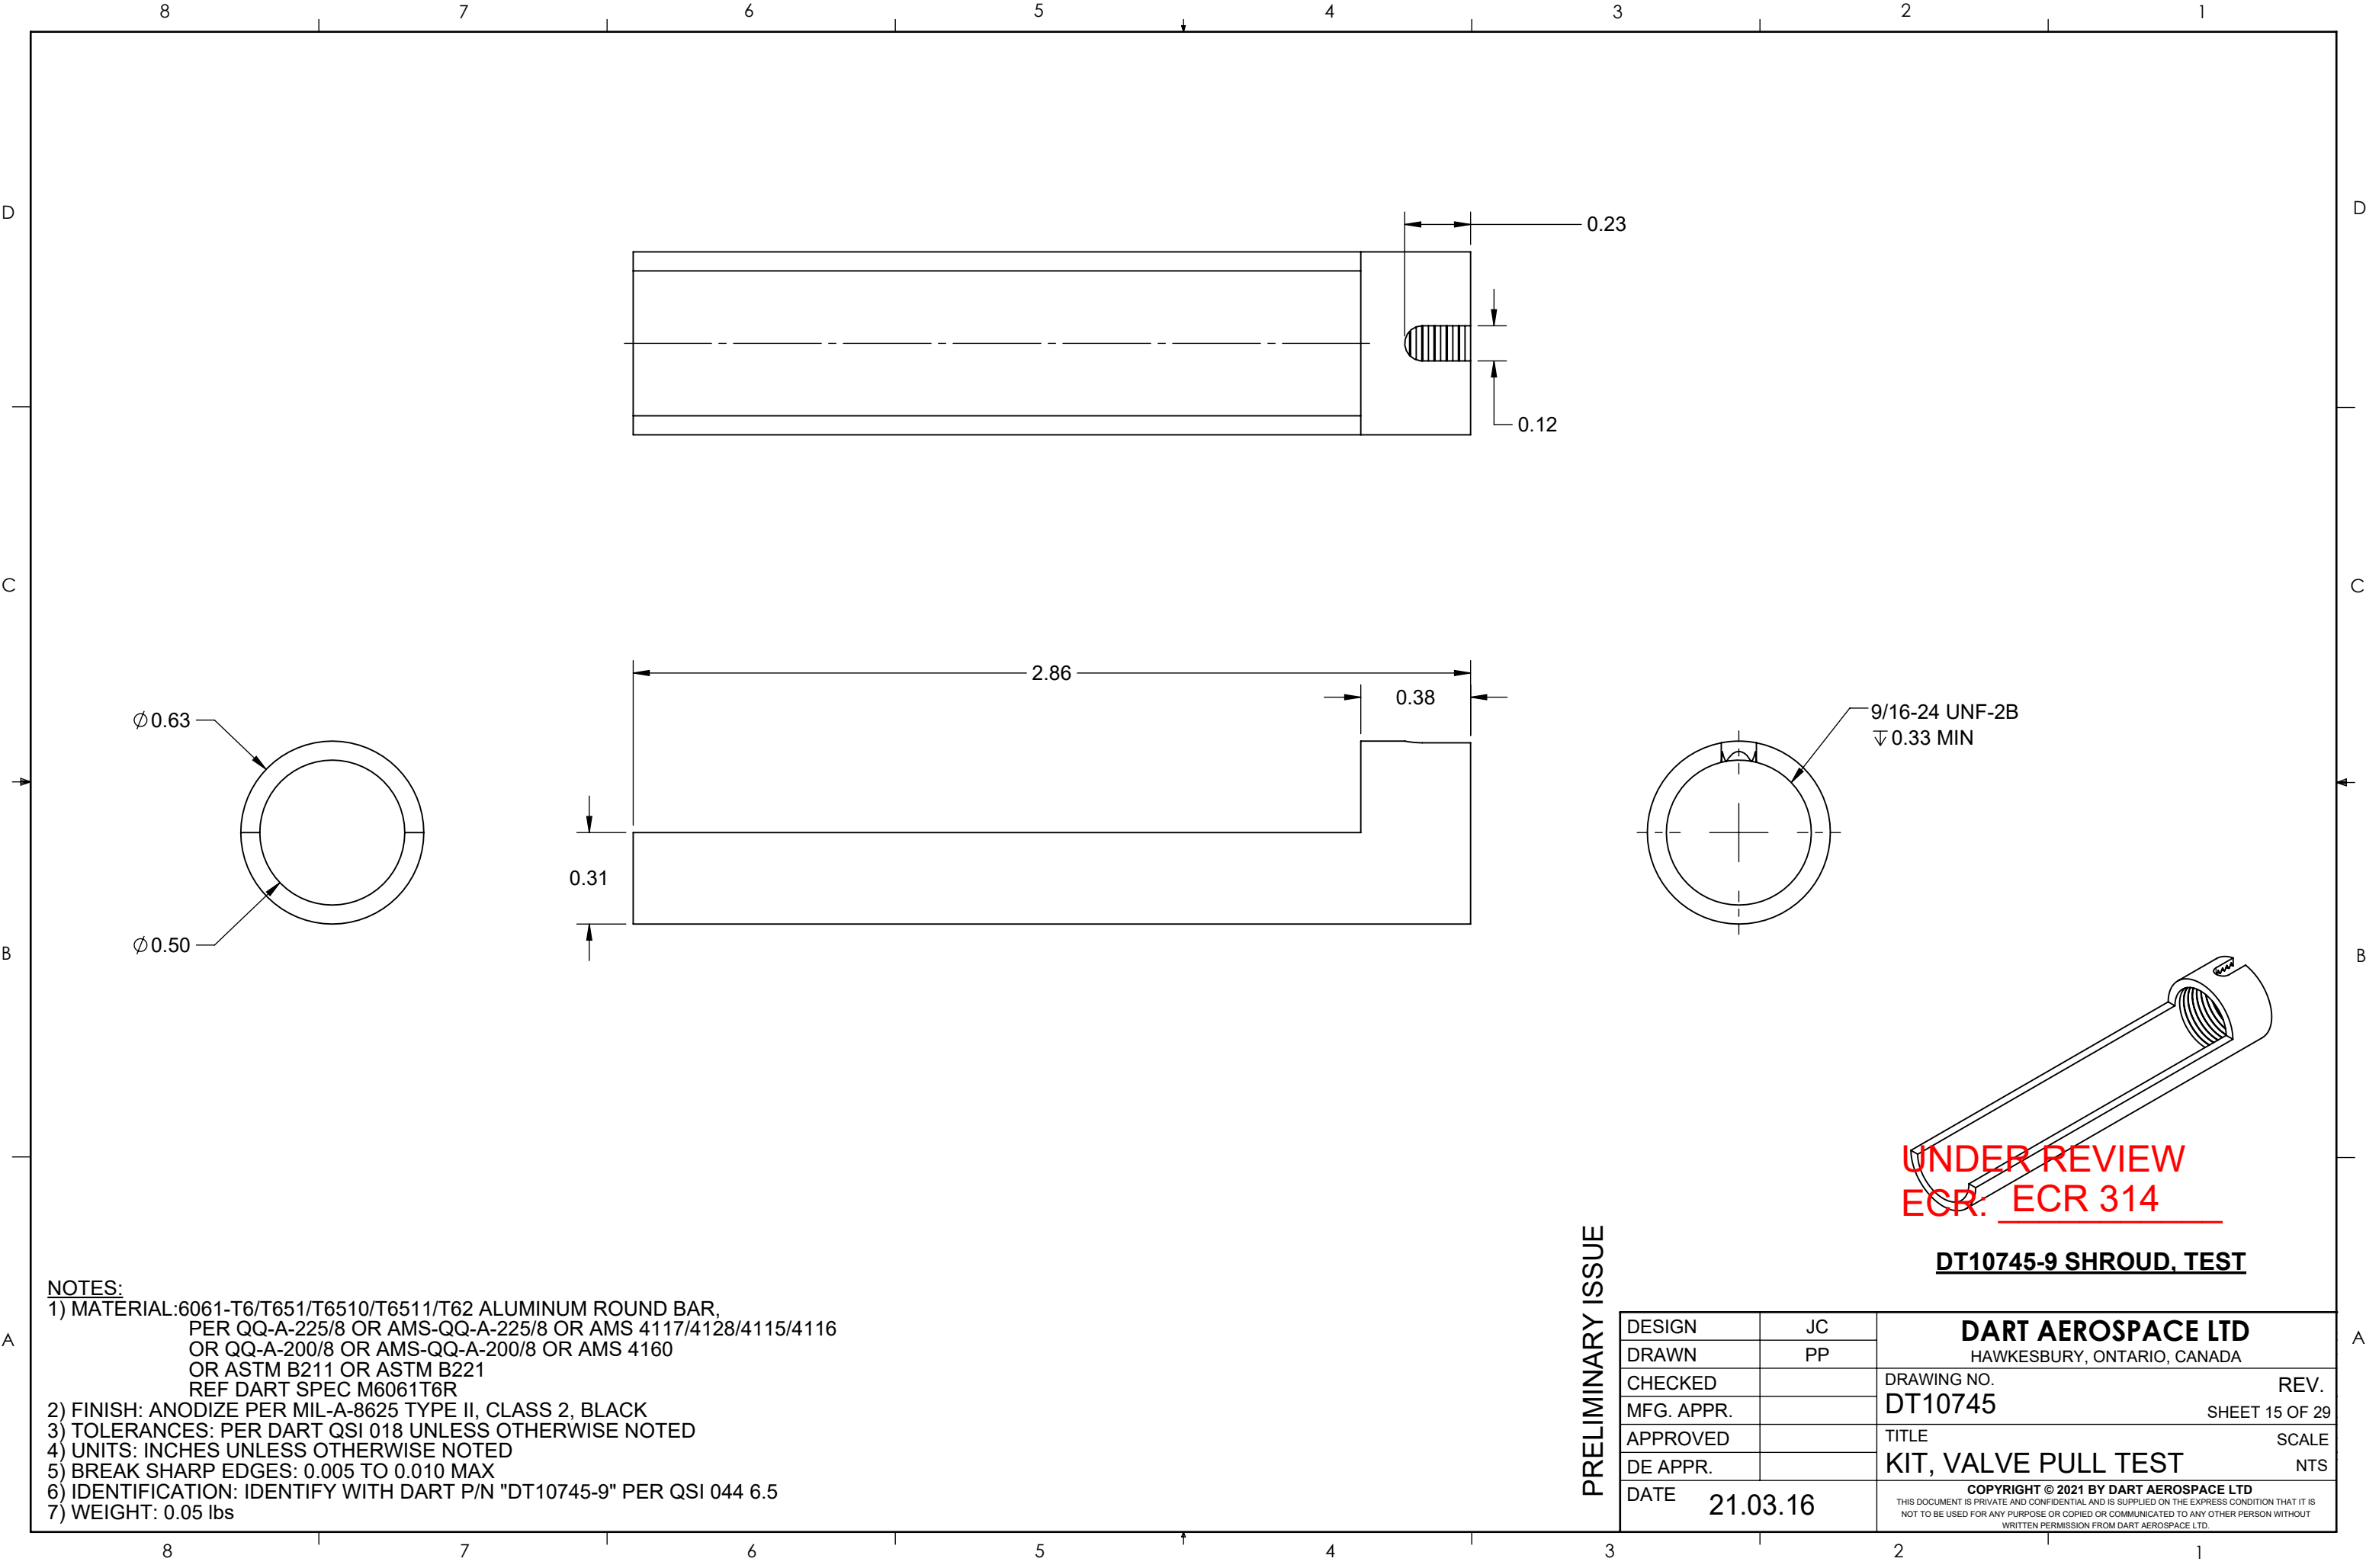

PRELIMINARY ISSUE


DESIGN	JC	DART AEROSPACE LTD HAWKESBURY, ONTARIO, CANADA
DRAWN	PP	
CHECKED		DRAWING NO. REV.
MFG. APPR.		DT10745 SHEET 15 OF 29
APPROVED		TITLE SCALE
DE APPR.		KIT, VALVE PULL TEST NTS
DATE	21.03.16	COPYRIGHT © 2021 BY DART AEROSPACE LTD THIS DOCUMENT IS PRIVATE AND CONFIDENTIAL AND IS SUPPLIED ON THE EXPRESS CONDITION THAT IT IS NOT TO BE USED FOR ANY PURPOSE OR COPIED OR COMMUNICATED TO ANY OTHER PERSON WITHOUT WRITTEN PERMISSION FROM DART AEROSPACE LTD.

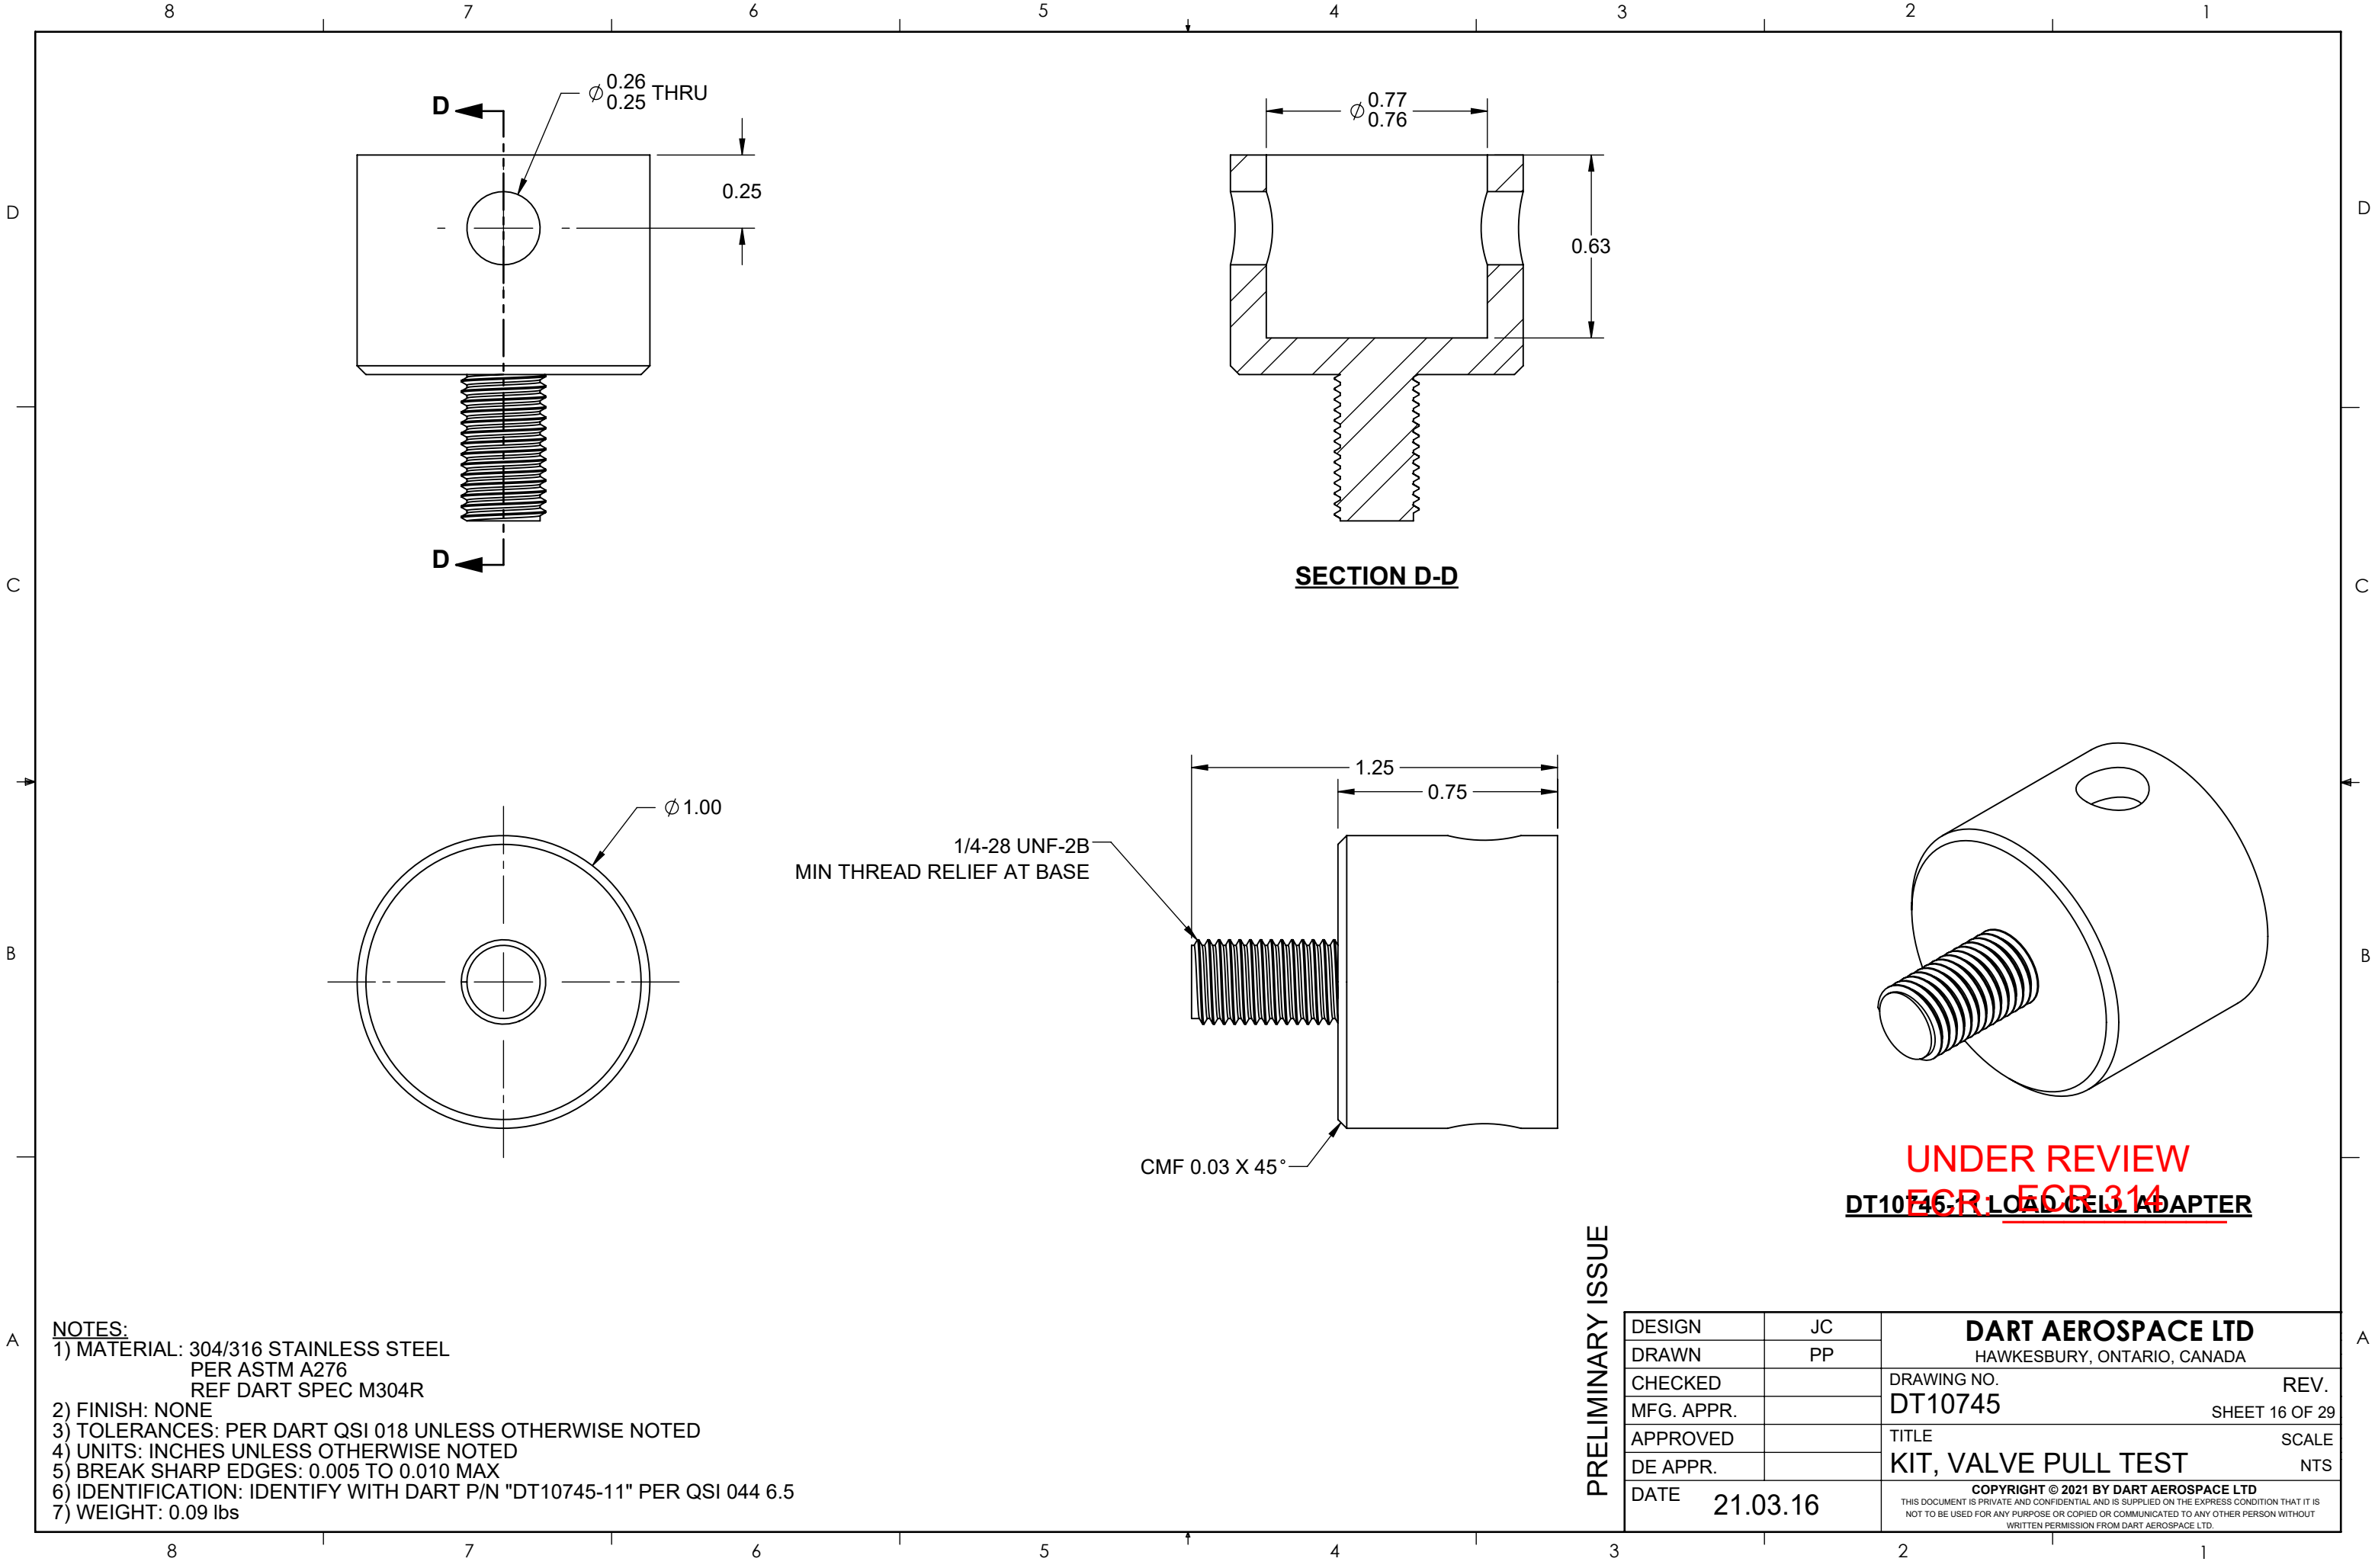

NOTES:
1) MATERIAL: 304/316 STAINLESS STEEL
PER ASTM A276
REF DART SPEC M304R
2) FINISH: NONE
3) TOLERANCES: PER DART QSI 018 UNLESS OTHERWISE NOTED
4) UNITS: INCHES UNLESS OTHERWISE NOTED
5) BREAK SHARP EDGES: 0.005 TO 0.010 MAX
6) IDENTIFICATION: IDENTIFY WITH DART P/N "DT10745-11" PER QSI 044 6.5
7) WEIGHT: 0.09 lbs

PRELIMINARY ISSUE

DESIGN	JC	DART AEROSPACE LTD HAWKESBURY, ONTARIO, CANADA	
DRAWN	PP		
CHECKED		DRAWING NO. DT10745	REV. SHEET 16 OF 29
MFG. APPR.		TITLE KIT, VALVE PULL TEST	
APPROVED			
DE APPR.		SCALE NTS	
DATE	21.03.16		
		COPYRIGHT © 2021 BY DART AEROSPACE LTD THIS DOCUMENT IS PRIVATE AND CONFIDENTIAL AND IS SUPPLIED ON THE EXPRESS CONDITION THAT IT IS NOT TO BE USED FOR ANY PURPOSE OR COPIED OR COMMUNICATED TO ANY OTHER PERSON WITHOUT WRITTEN PERMISSION FROM DART AEROSPACE LTD.	

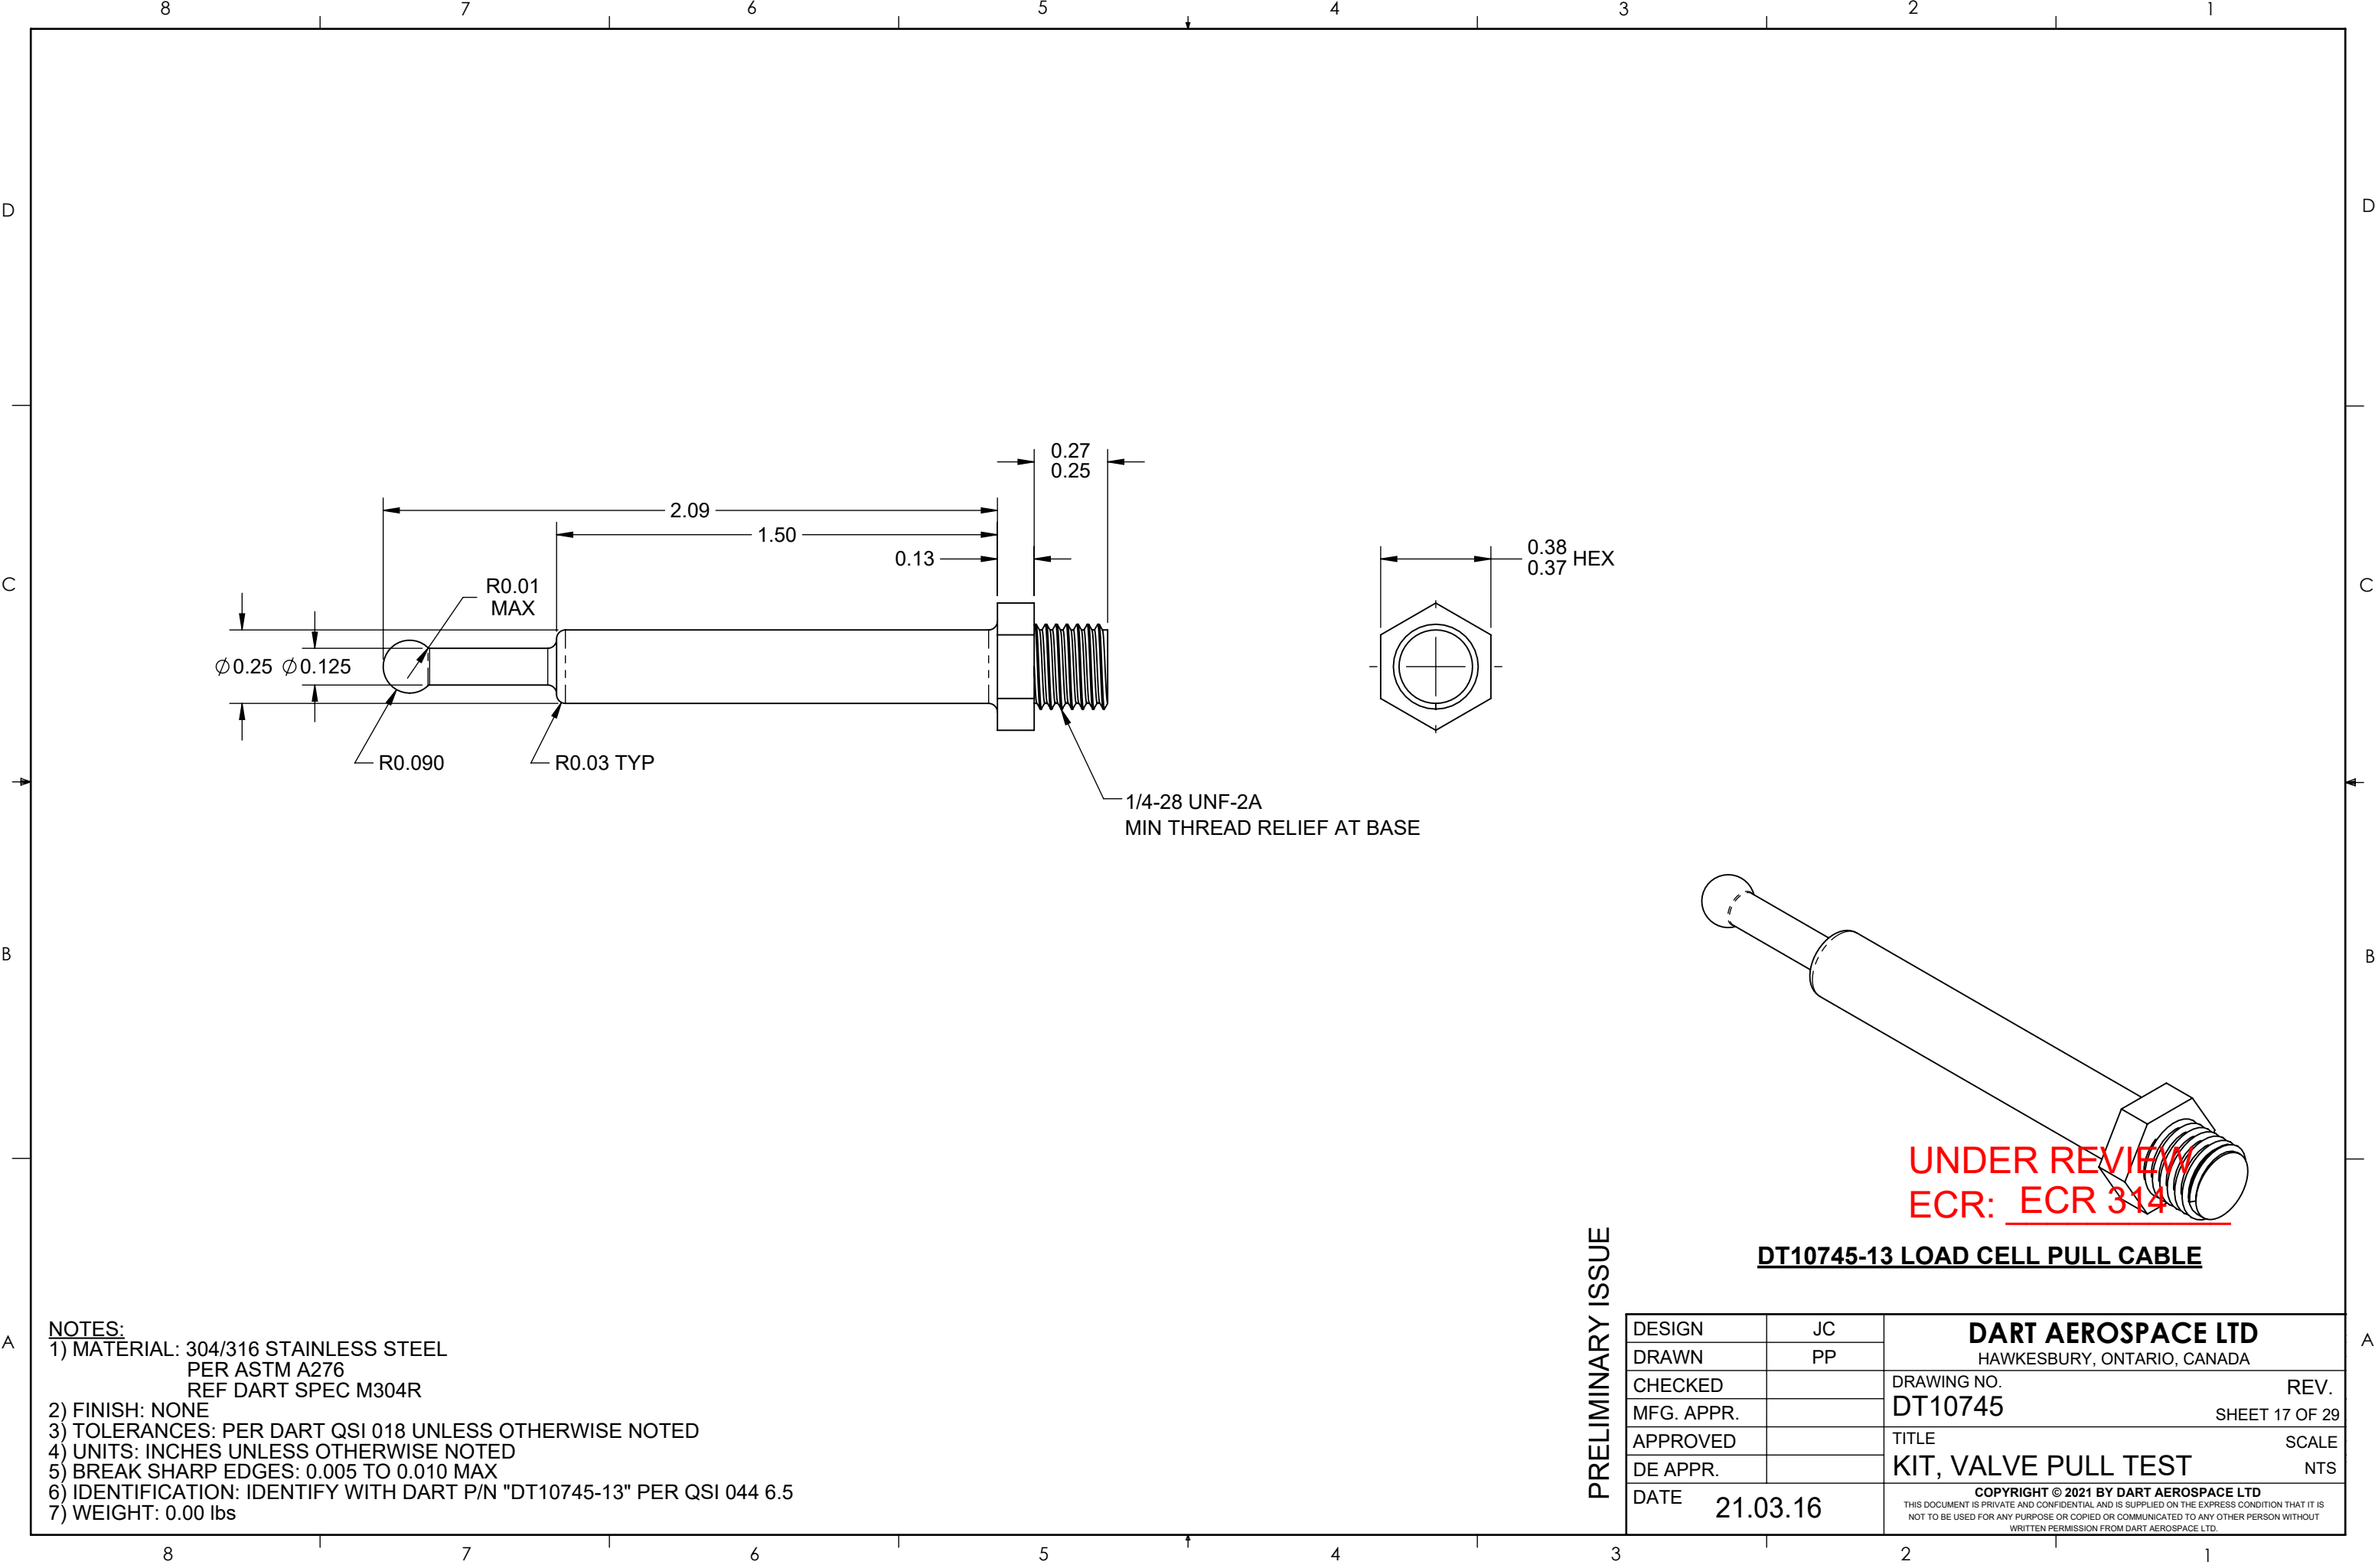

UNDER REVIEW
ECR: ECR 314

DT10745-13 LOAD CELL PULL CABLE

- NOTES:
1) MATERIAL: 304/316 STAINLESS STEEL
PER ASTM A276
REF DART SPEC M304R
2) FINISH: NONE
3) TOLERANCES: PER DART QSI 018 UNLESS OTHERWISE NOTED
4) UNITS: INCHES UNLESS OTHERWISE NOTED
5) BREAK SHARP EDGES: 0.005 TO 0.010 MAX
6) IDENTIFICATION: IDENTIFY WITH DART P/N "DT10745-13" PER QSI 044 6.5
7) WEIGHT: 0.00 lbs

PRELIMINARY ISSUE

DESIGN	JC	DART AEROSPACE LTD HAWKESBURY, ONTARIO, CANADA	
DRAWN	PP		
CHECKED		DRAWING NO. DT10745	REV. SHEET 17 OF 29
MFG. APPR.		TITLE KIT, VALVE PULL TEST	
APPROVED			
DE APPR.		SCALE NTS	
DATE	21.03.16		
		COPYRIGHT © 2021 BY DART AEROSPACE LTD THIS DOCUMENT IS PRIVATE AND CONFIDENTIAL AND IS SUPPLIED ON THE EXPRESS CONDITION THAT IT IS NOT TO BE USED FOR ANY PURPOSE OR COPIED OR COMMUNICATED TO ANY OTHER PERSON WITHOUT WRITTEN PERMISSION FROM DART AEROSPACE LTD.	



$\phi = 0.261$ THRU



SECTION E-E




DT10745-15 ADAPTER, RESERVOIR

PRELIMINARY ISSUE

NOTES:

- 1) MATERIAL: 6061-T6/T651/T6510/T6511/T62 ALUMINUM BAR
PER QQ-A-225/8 OR AMS-QQ-A-225/8 OR AMS 4117/4128/4115/4116
OR QQ-A-200/8 OR AMS-QQ-A-200/8 OR AMS 4160
OR ASTM B211 OR ASTM B221
REF DART SPEC M6061T6B
- 2) FINISH: ANODIZE PER MIL-A-8625 TYPE II, CLASS 2, BLACK
- 3) TOLERANCES: PER DART QSI 018 UNLESS OTHERWISE NOTED
- 4) UNITS: INCHES UNLESS OTHERWISE NOTED
- 5) BREAK SHARP EDGES: 0.005 TO 0.010 MAX
- 6) IDENTIFICATION: IDENTIFY WITH DART P/N "DT10745-15" USING FINE POINT PERMANENT INK MARKER
- 7) WEIGHT: 0.61 lbs


THIS DOCUMENT IS PRIVATE AND CONFIDENTIAL AND IS SUPPLIED ON THE EXPRESS CONDITION THAT IT IS NOT TO BE USED FOR ANY PURPOSE OR COPIED OR COMMUNICATED TO ANY OTHER PERSON WITHOUT WRITTEN PERMISSION FROM DART AEROSPACE LTD

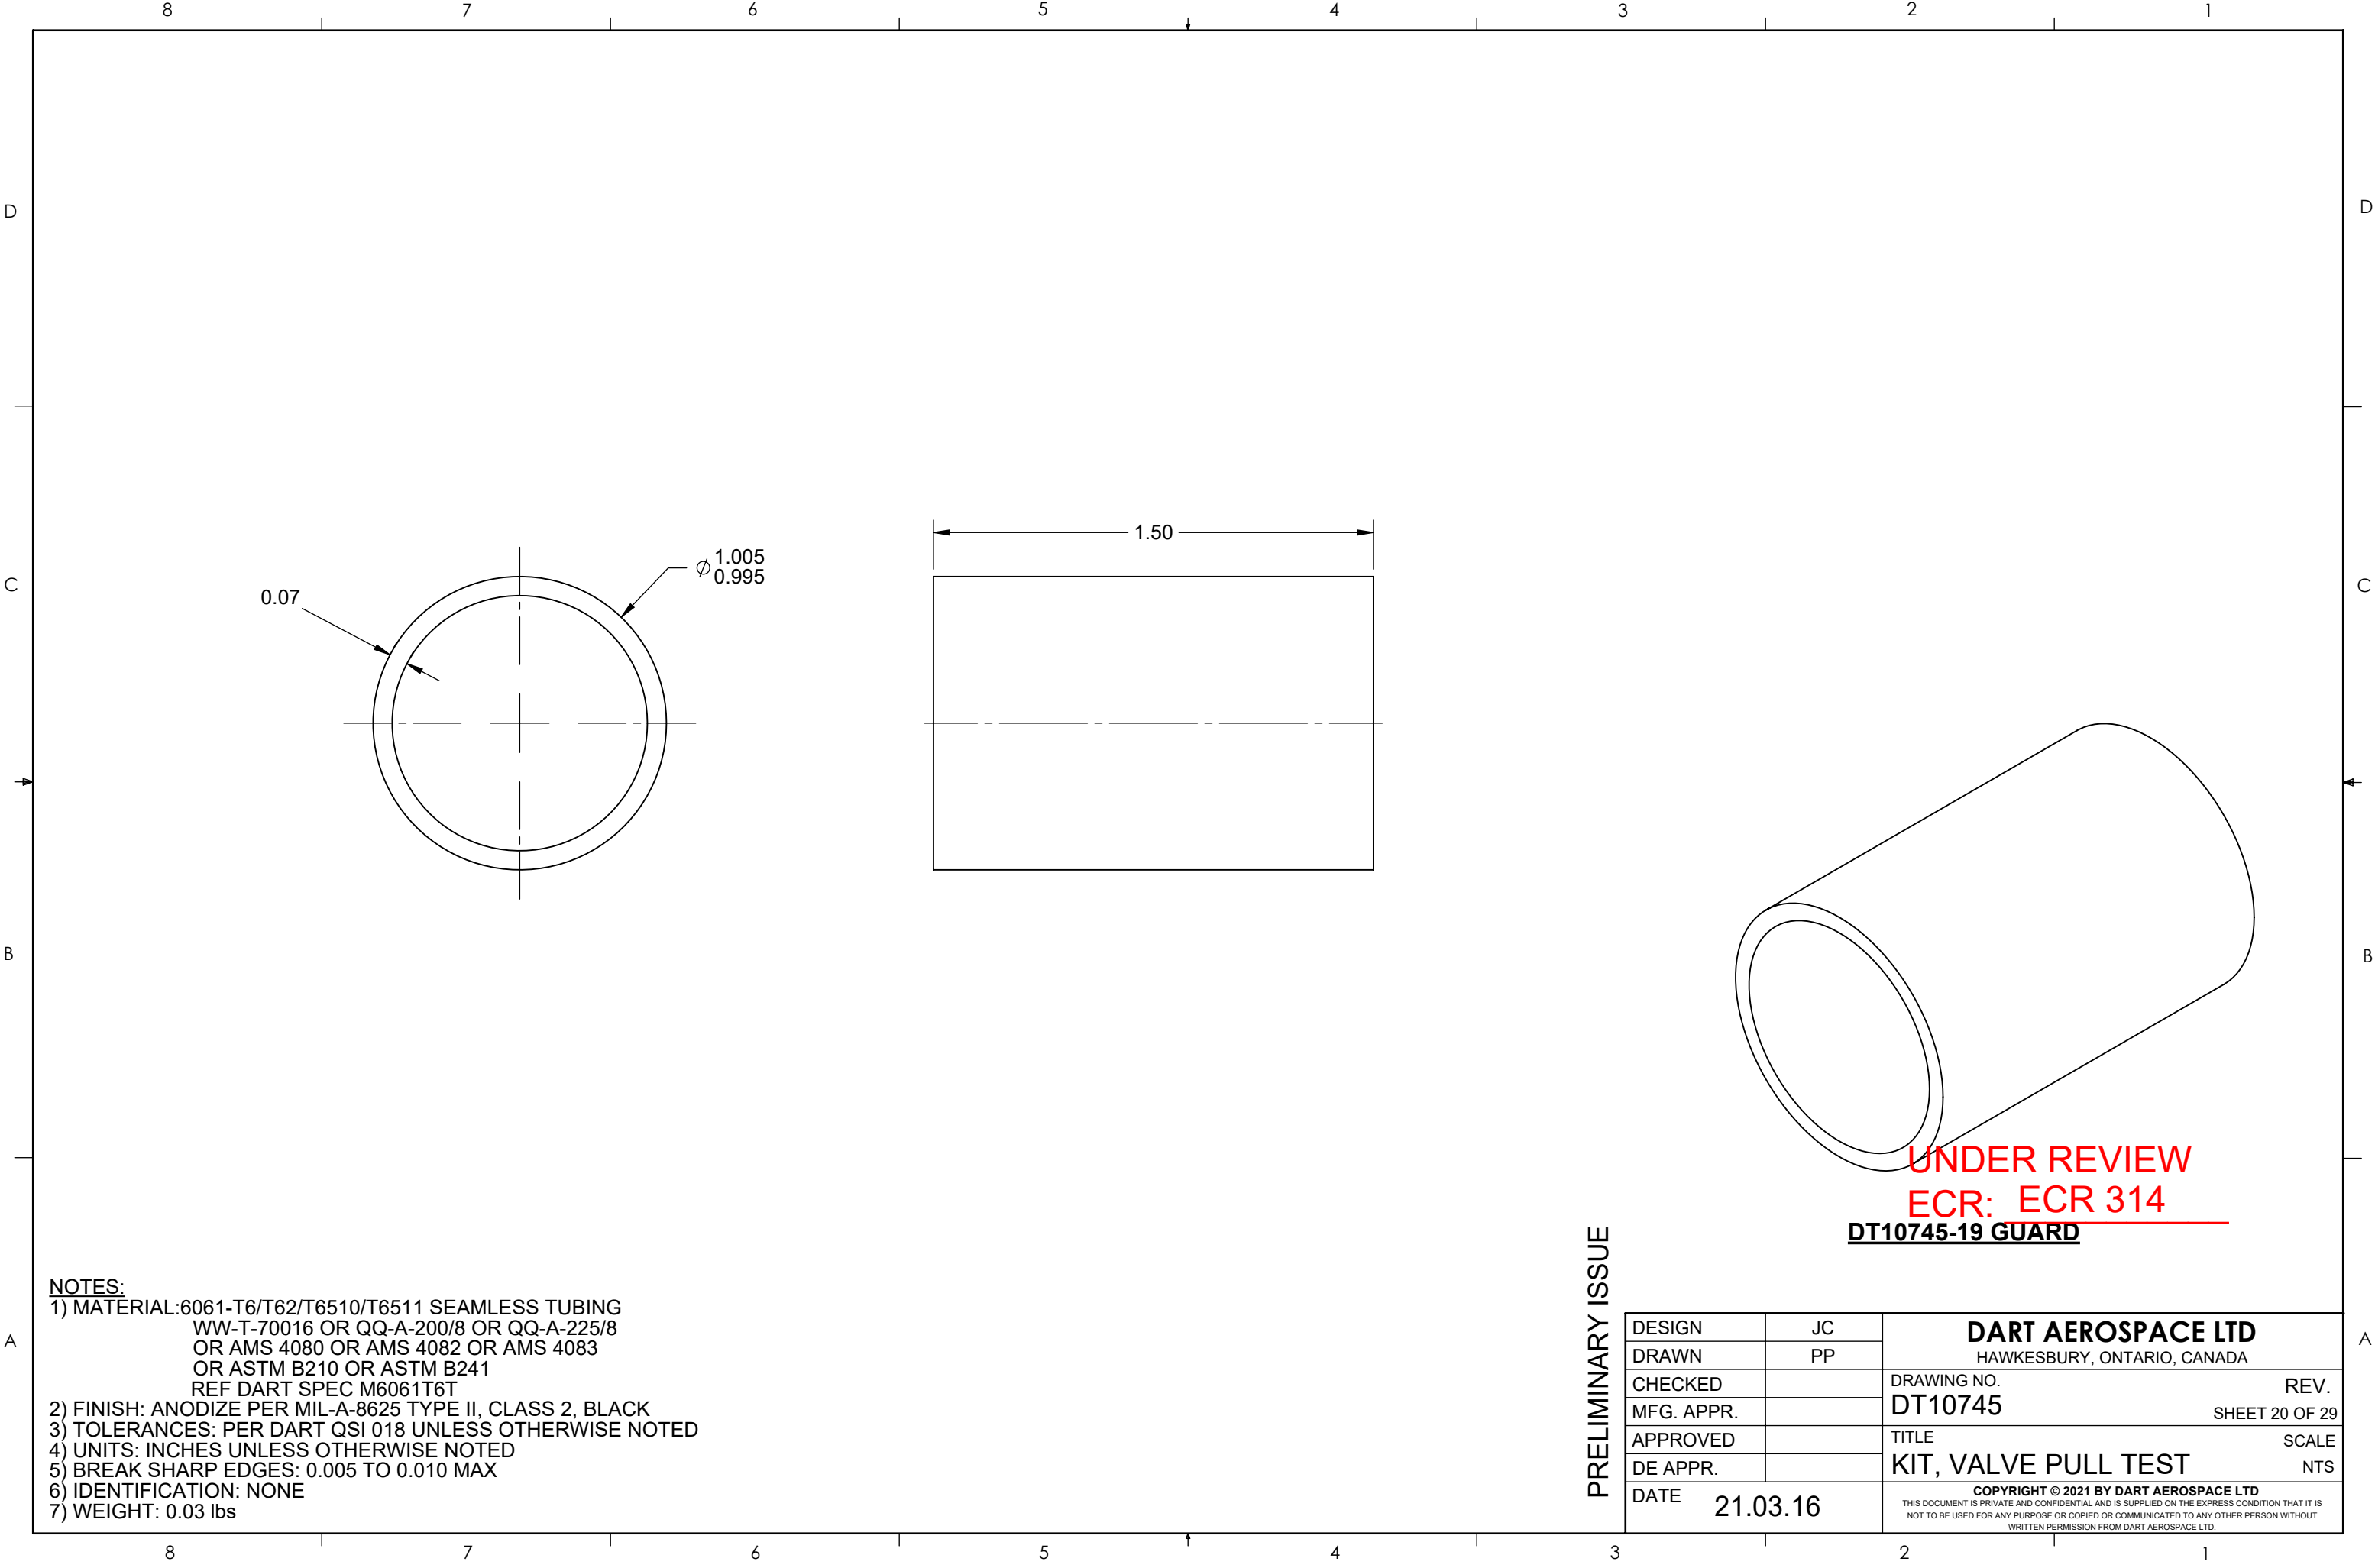

NOTES:
1) MATERIAL: 6061-T6/T62/T6510/T6511 SEAMLESS TUBING
WW-T-70016 OR QQ-A-200/8 OR QQ-A-225/8
OR AMS 4080 OR AMS 4082 OR AMS 4083
OR ASTM B210 OR ASTM B241
REF DART SPEC M6061T6T
2) FINISH: ANODIZE PER MIL-A-8625 TYPE II, CLASS 2, BLACK
3) TOLERANCES: PER DART QSI 018 UNLESS OTHERWISE NOTED
4) UNITS: INCHES UNLESS OTHERWISE NOTED
5) BREAK SHARP EDGES: 0.005 TO 0.010 MAX
6) IDENTIFICATION: NONE
7) WEIGHT: 0.03 lbs

PRELIMINARY ISSUE

DESIGN	JC	DART AEROSPACE LTD HAWKESBURY, ONTARIO, CANADA
DRAWN	PP	
CHECKED		DRAWING NO. REV.
MFG. APPR.		DT10745 SHEET 20 OF 29
APPROVED		TITLE SCALE
DE APPR.		KIT, VALVE PULL TEST NTS
DATE	21.03.16	COPYRIGHT © 2021 BY DART AEROSPACE LTD THIS DOCUMENT IS PRIVATE AND CONFIDENTIAL AND IS SUPPLIED ON THE EXPRESS CONDITION THAT IT IS NOT TO BE USED FOR ANY PURPOSE OR COPIED OR COMMUNICATED TO ANY OTHER PERSON WITHOUT WRITTEN PERMISSION FROM DART AEROSPACE LTD.

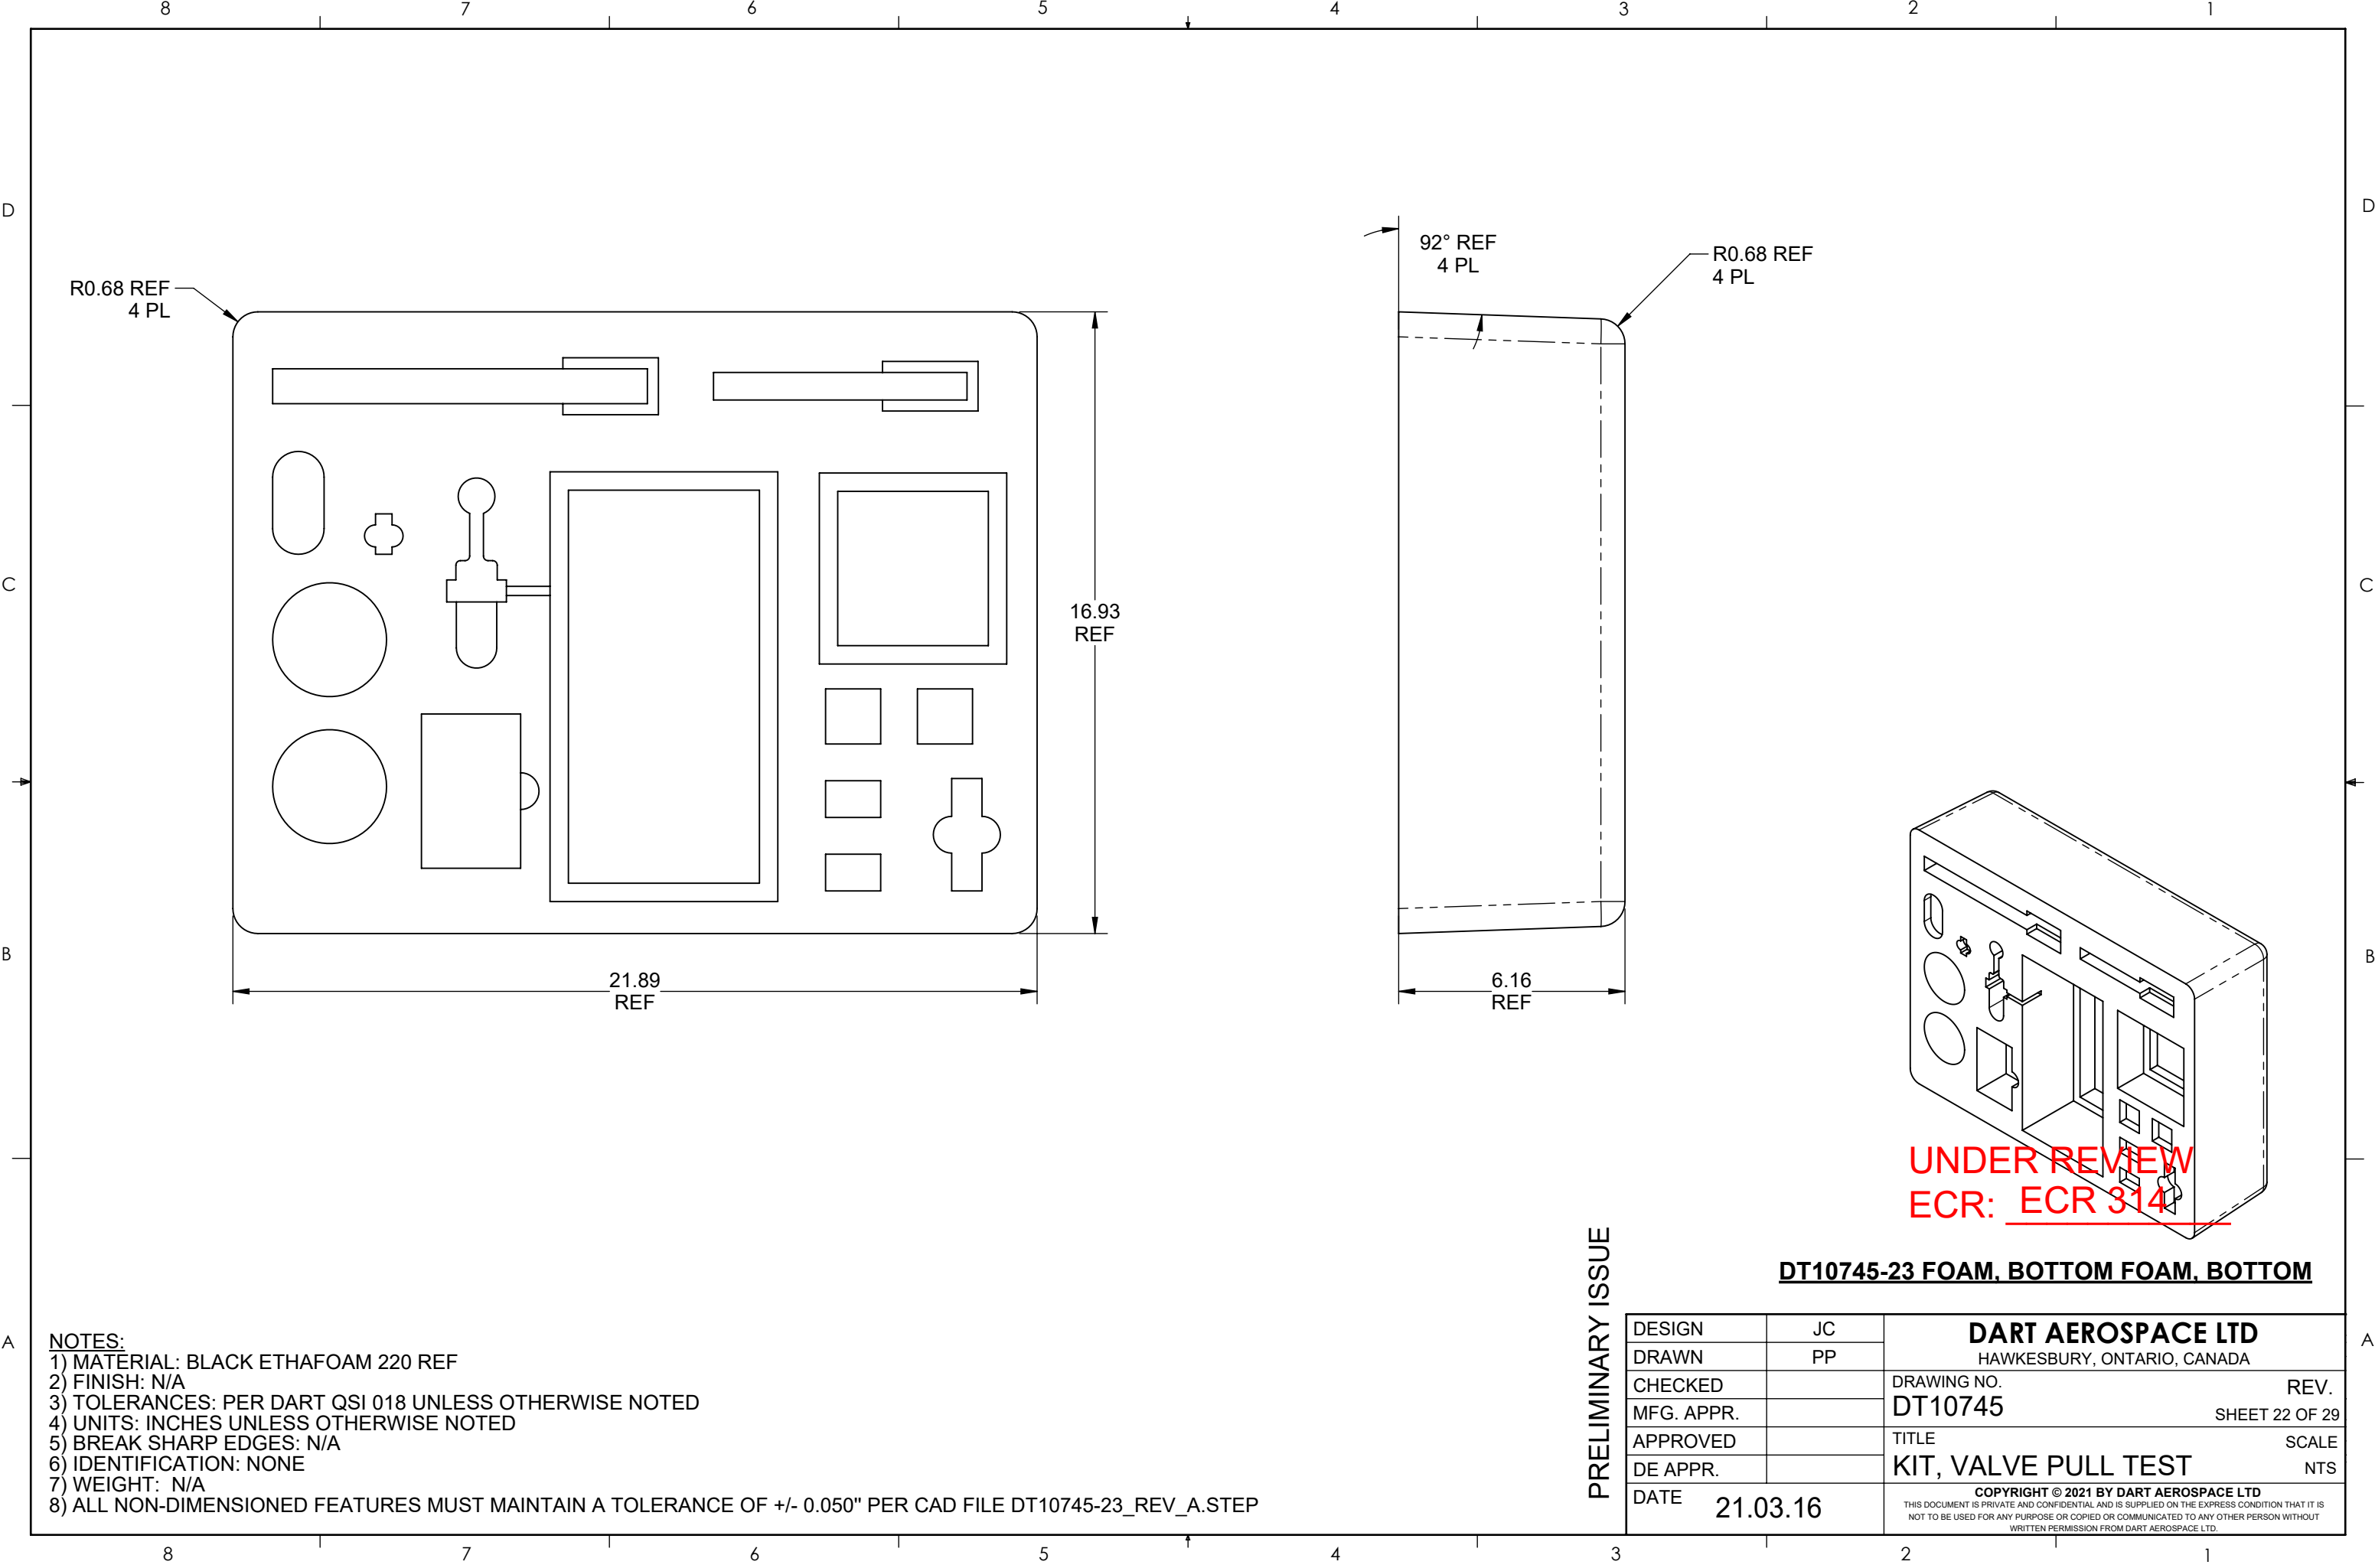


- NOTES:
- 1) MATERIAL: BLACK ETHAFOAM 220 REF
 - 2) FINISH: N/A
 - 3) TOLERANCES: PER DART QSI 018 UNLESS OTHERWISE NOTED
 - 4) UNITS: INCHES UNLESS OTHERWISE NOTED
 - 5) BREAK SHARP EDGES: N/A
 - 6) IDENTIFICATION: NONE
 - 7) WEIGHT: N/A
 - 8) ALL NON-DIMENSIONED FEATURES MUST MAINTAIN A TOLERANCE OF +/- 0.050" PER CAD FILE DT10745-23_REV_A.STEP

PRELIMINARY ISSUE

DESIGN	JC	DART AEROSPACE LTD HAWKESBURY, ONTARIO, CANADA	
DRAWN	PP		
CHECKED		DRAWING NO.	REV.
MFG. APPR.		DT10745	SHEET 22 OF 29
APPROVED		TITLE	SCALE
DE APPR.		KIT, VALVE PULL TEST	NTS
DATE	21.03.16	COPYRIGHT © 2021 BY DART AEROSPACE LTD <small>THIS DOCUMENT IS PRIVATE AND CONFIDENTIAL AND IS SUPPLIED ON THE EXPRESS CONDITION THAT IT IS NOT TO BE USED FOR ANY PURPOSE OR COPIED OR COMMUNICATED TO ANY OTHER PERSON WITHOUT WRITTEN PERMISSION FROM DART AEROSPACE LTD.</small>	

DT10745-23 FOAM, BOTTOM FOAM, BOTTOM

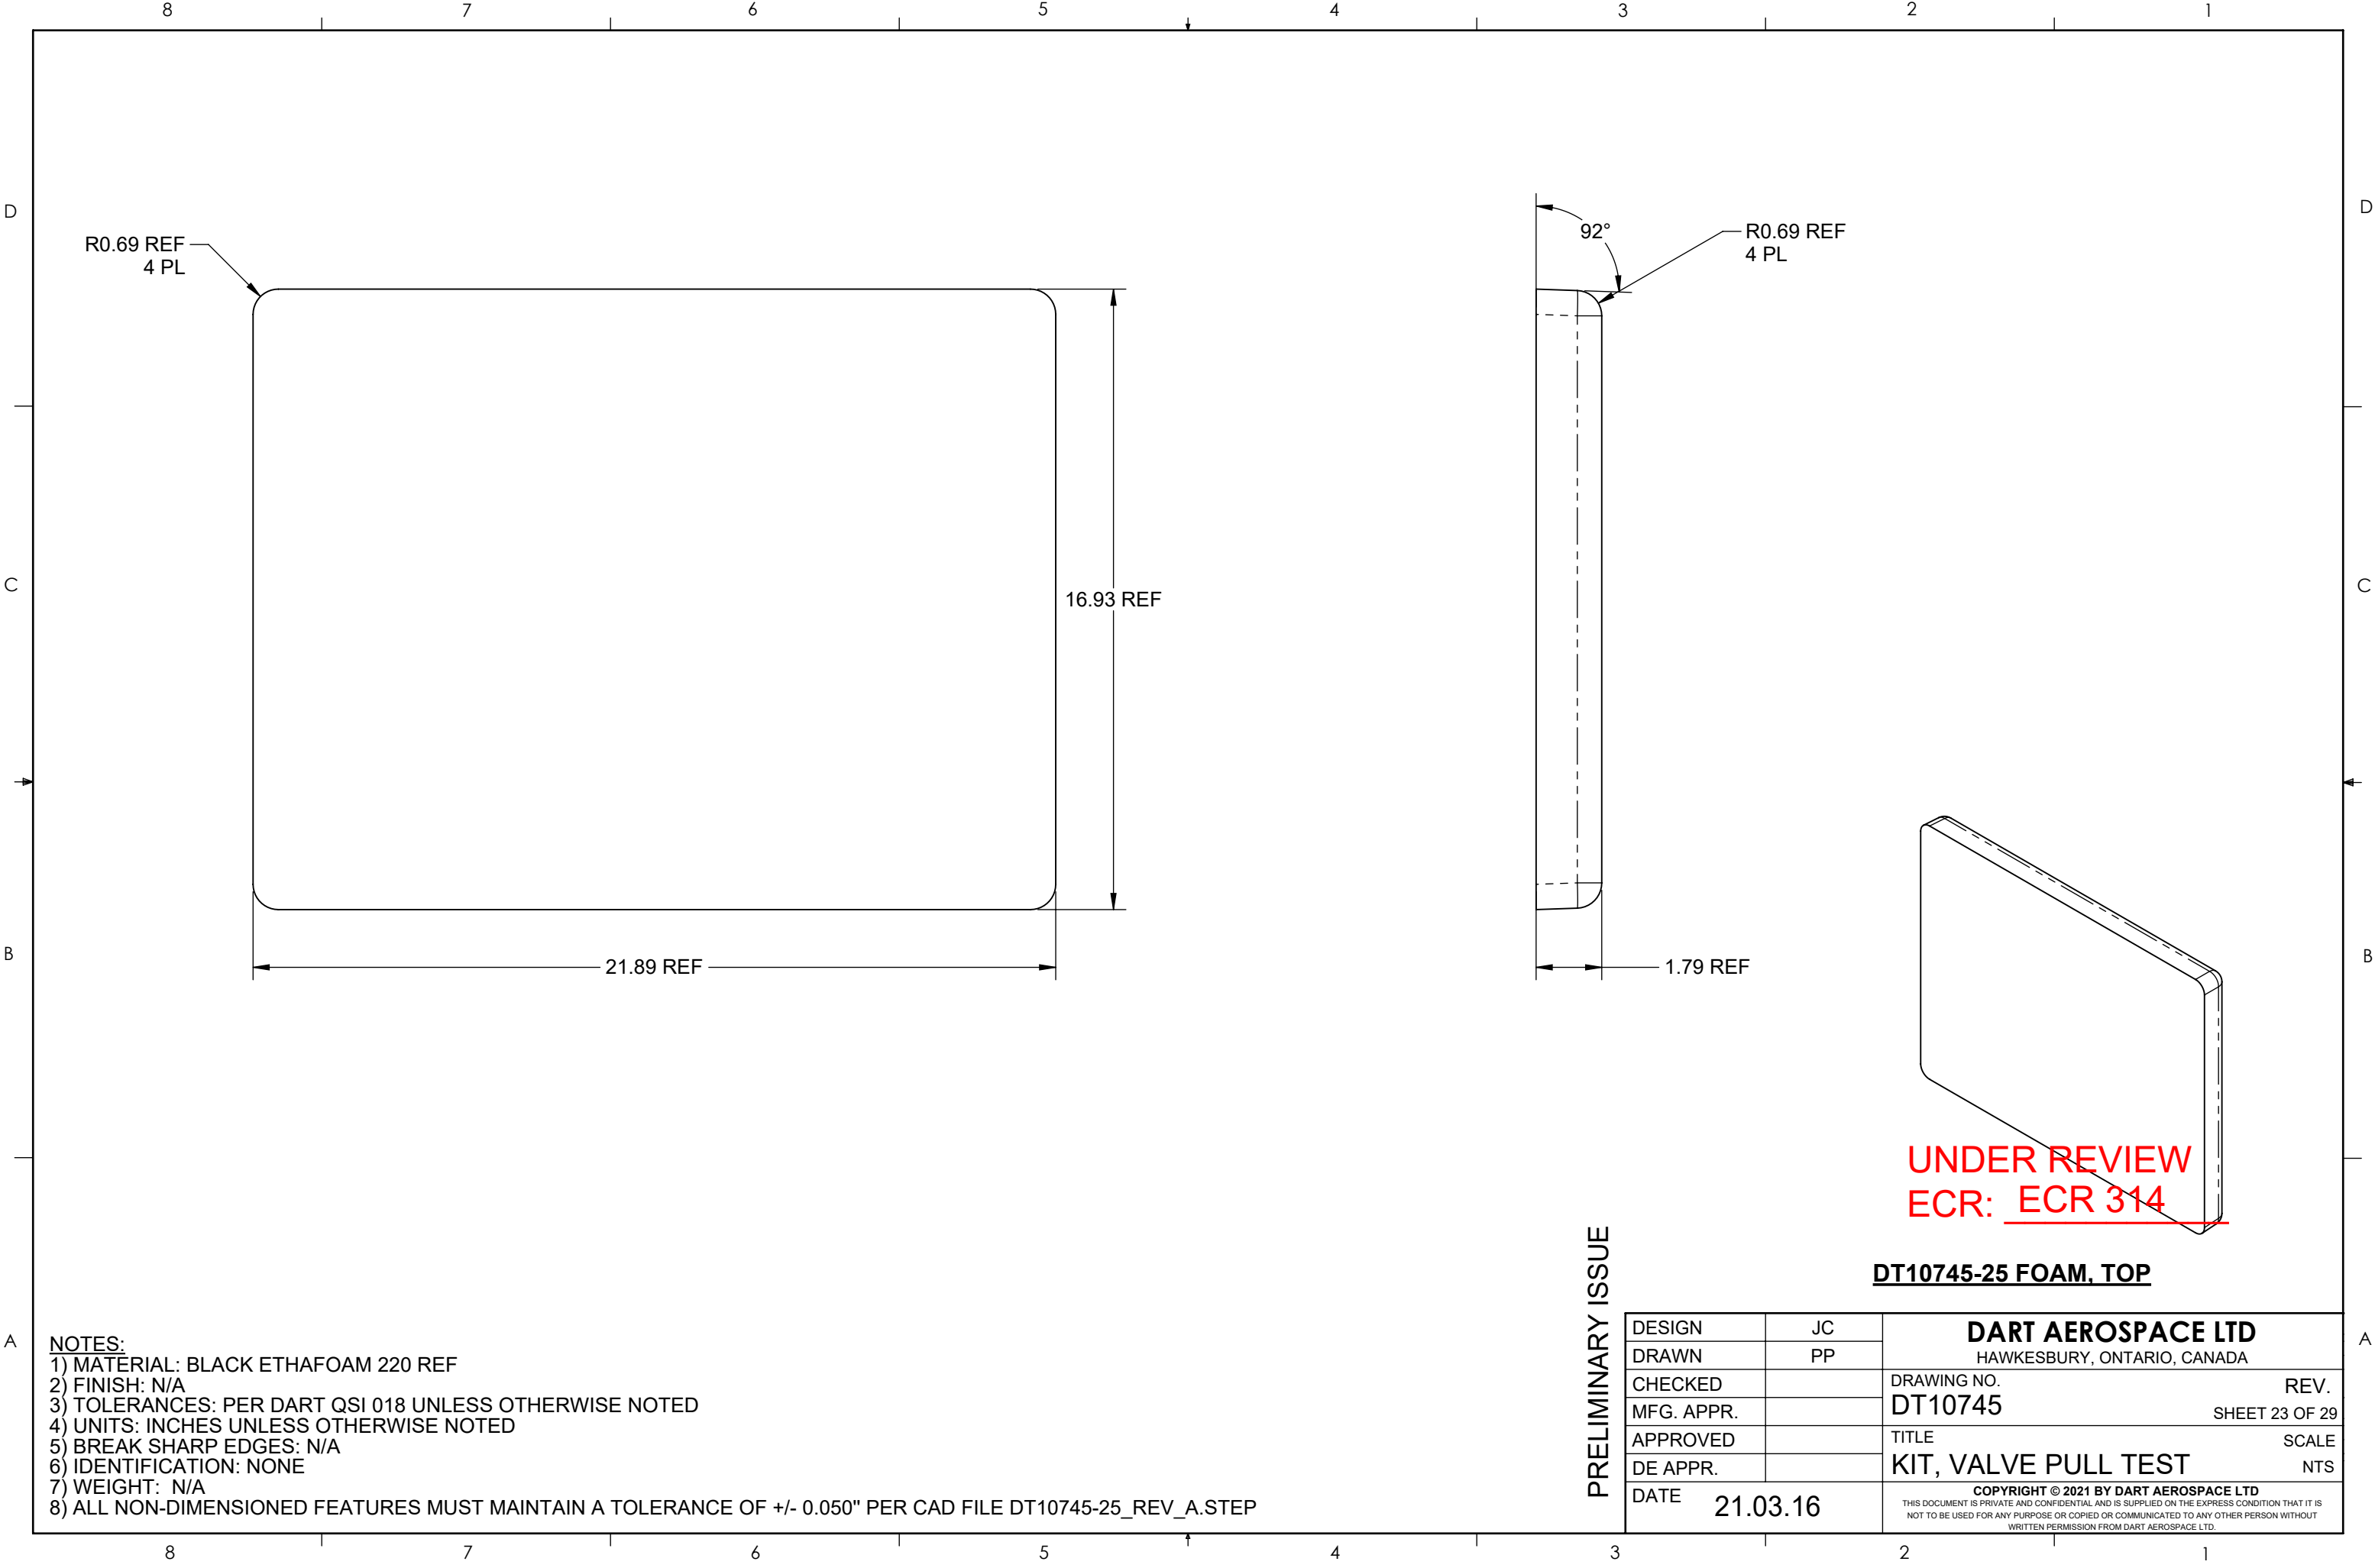


NOTES:

- 1) MATERIAL: BLACK ETHAFOAM 220 REF
- 2) FINISH: N/A
- 3) TOLERANCES: PER DART QSI 018 UNLESS OTHERWISE NOTED
- 4) UNITS: INCHES UNLESS OTHERWISE NOTED
- 5) BREAK SHARP EDGES: N/A
- 6) IDENTIFICATION: NONE
- 7) WEIGHT: N/A
- 8) ALL NON-DIMENSIONED FEATURES MUST MAINTAIN A TOLERANCE OF +/- 0.050" PER CAD FILE DT10745-25_REV_A.STEP

PRELIMINARY ISSUE

DESIGN	JC	DART AEROSPACE LTD HAWKESBURY, ONTARIO, CANADA	
DRAWN	PP		
CHECKED		DRAWING NO. DT10745	REV. SHEET 23 OF 29
MFG. APPR.		TITLE KIT, VALVE PULL TEST	
APPROVED			
DE APPR.		SCALE NTS	
DATE	21.03.16		
		COPYRIGHT © 2021 BY DART AEROSPACE LTD THIS DOCUMENT IS PRIVATE AND CONFIDENTIAL AND IS SUPPLIED ON THE EXPRESS CONDITION THAT IT IS NOT TO BE USED FOR ANY PURPOSE OR COPIED OR COMMUNICATED TO ANY OTHER PERSON WITHOUT WRITTEN PERMISSION FROM DART AEROSPACE LTD.	

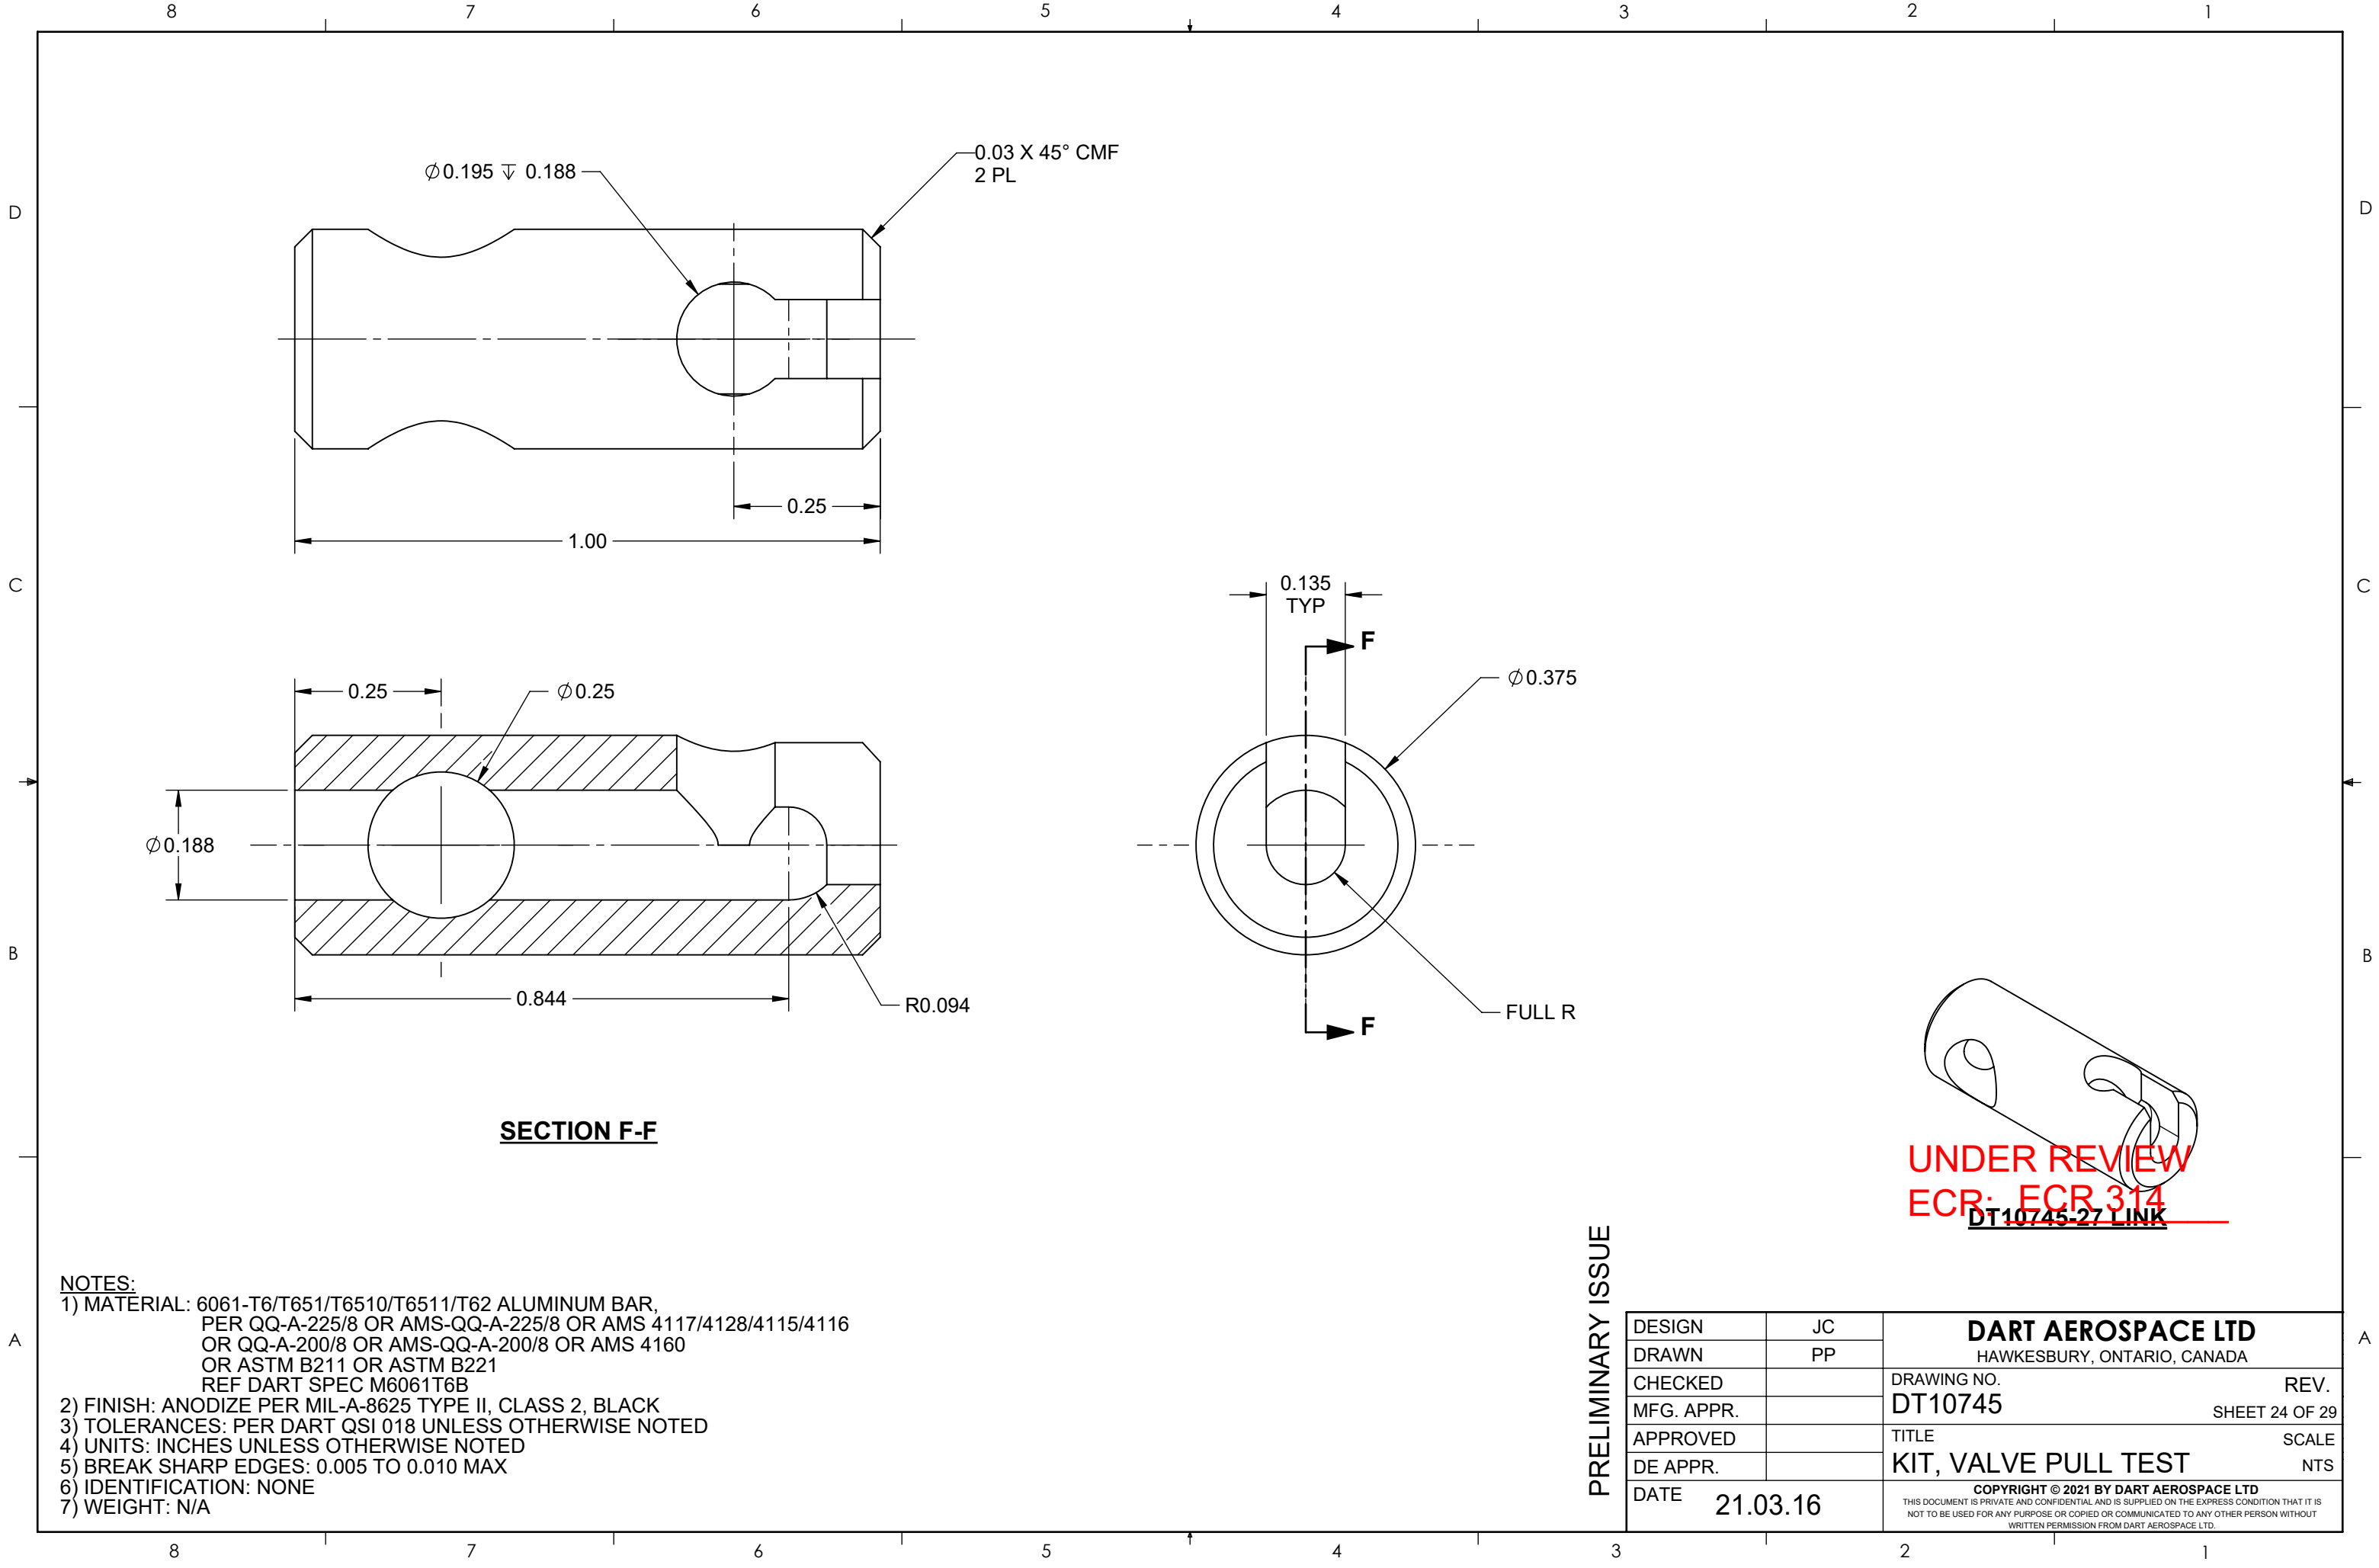


NOTES:

- 1) MATERIAL: 6061-T6/T651/T6510/T6511/T62 ALUMINUM BAR, PER QQ-A-225/8 OR AMS-QQ-A-225/8 OR AMS 4117/4128/4115/4116 OR QQ-A-200/8 OR AMS-QQ-A-200/8 OR AMS 4160 OR ASTM B211 OR ASTM B221 REF DART SPEC M6061T6B
- 2) FINISH: ANODIZE PER MIL-A-8625 TYPE II, CLASS 2, BLACK
- 3) TOLERANCES: PER DART QSI 018 UNLESS OTHERWISE NOTED
- 4) UNITS: INCHES UNLESS OTHERWISE NOTED
- 5) BREAK SHARP EDGES: 0.005 TO 0.010 MAX
- 6) IDENTIFICATION: NONE
- 7) WEIGHT: N/A

PRELIMINARY ISSUE


DESIGN	JC	DART AEROSPACE LTD HAWKESBURY, ONTARIO, CANADA
DRAWN	PP	
CHECKED		DRAWING NO. REV.
MFG. APPR.		DT10745 SHEET 24 OF 29
APPROVED		TITLE SCALE
DE APPR.		KIT, VALVE PULL TEST NTS
DATE	21.03.16	COPYRIGHT © 2021 BY DART AEROSPACE LTD THIS DOCUMENT IS PRIVATE AND CONFIDENTIAL AND IS SUPPLIED ON THE EXPRESS CONDITION THAT IT IS NOT TO BE USED FOR ANY PURPOSE OR COPIED OR COMMUNICATED TO ANY OTHER PERSON WITHOUT WRITTEN PERMISSION FROM DART AEROSPACE LTD.



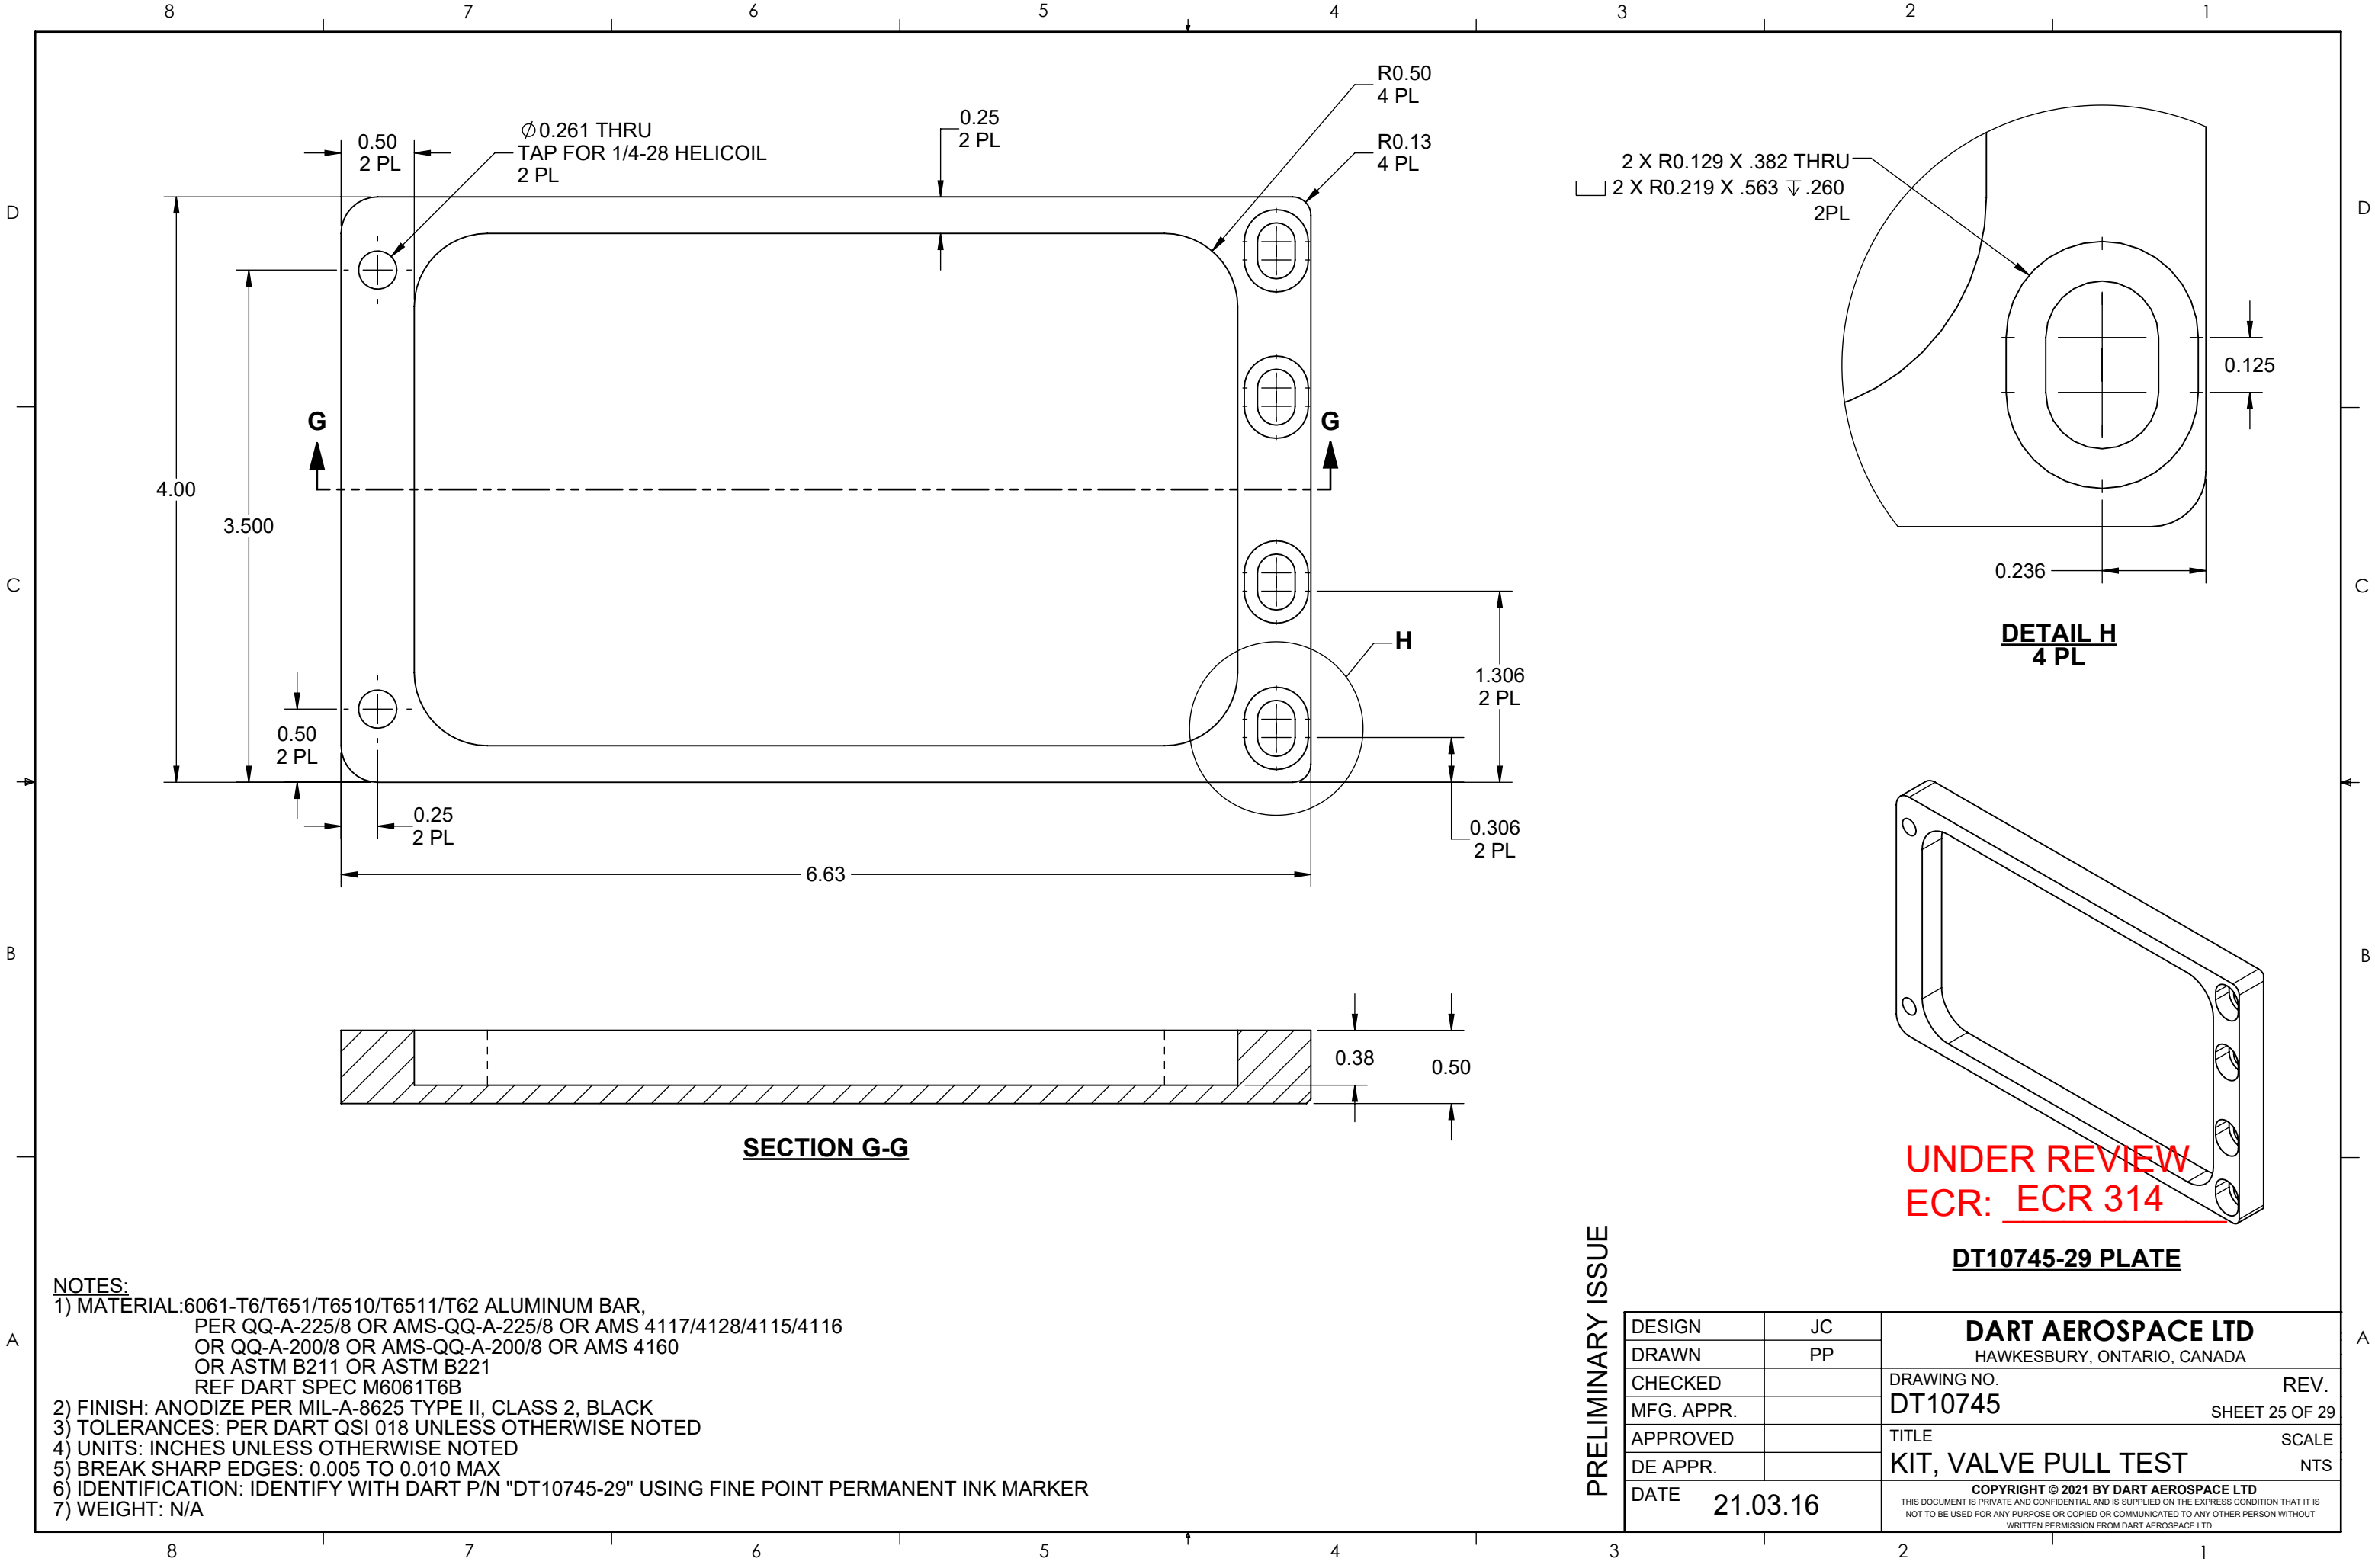

PRELIMINARY ISSUE

DESIGN	JC	DART AEROSPACE LTD HAWKESBURY, ONTARIO, CANADA	
DRAWN	PP		
CHECKED		DRAWING NO. DT10745	REV. SHEET 25 OF 29
MFG. APPR.		TITLE KIT, VALVE PULL TEST	SCALE NTS
APPROVED			
DE APPR.			
DATE	21.03.16	COPYRIGHT © 2021 BY DART AEROSPACE LTD THIS DOCUMENT IS PRIVATE AND CONFIDENTIAL AND IS SUPPLIED ON THE EXPRESS CONDITION THAT IT IS NOT TO BE USED FOR ANY PURPOSE OR COPIED OR COMMUNICATED TO ANY OTHER PERSON WITHOUT WRITTEN PERMISSION FROM DART AEROSPACE LTD.	

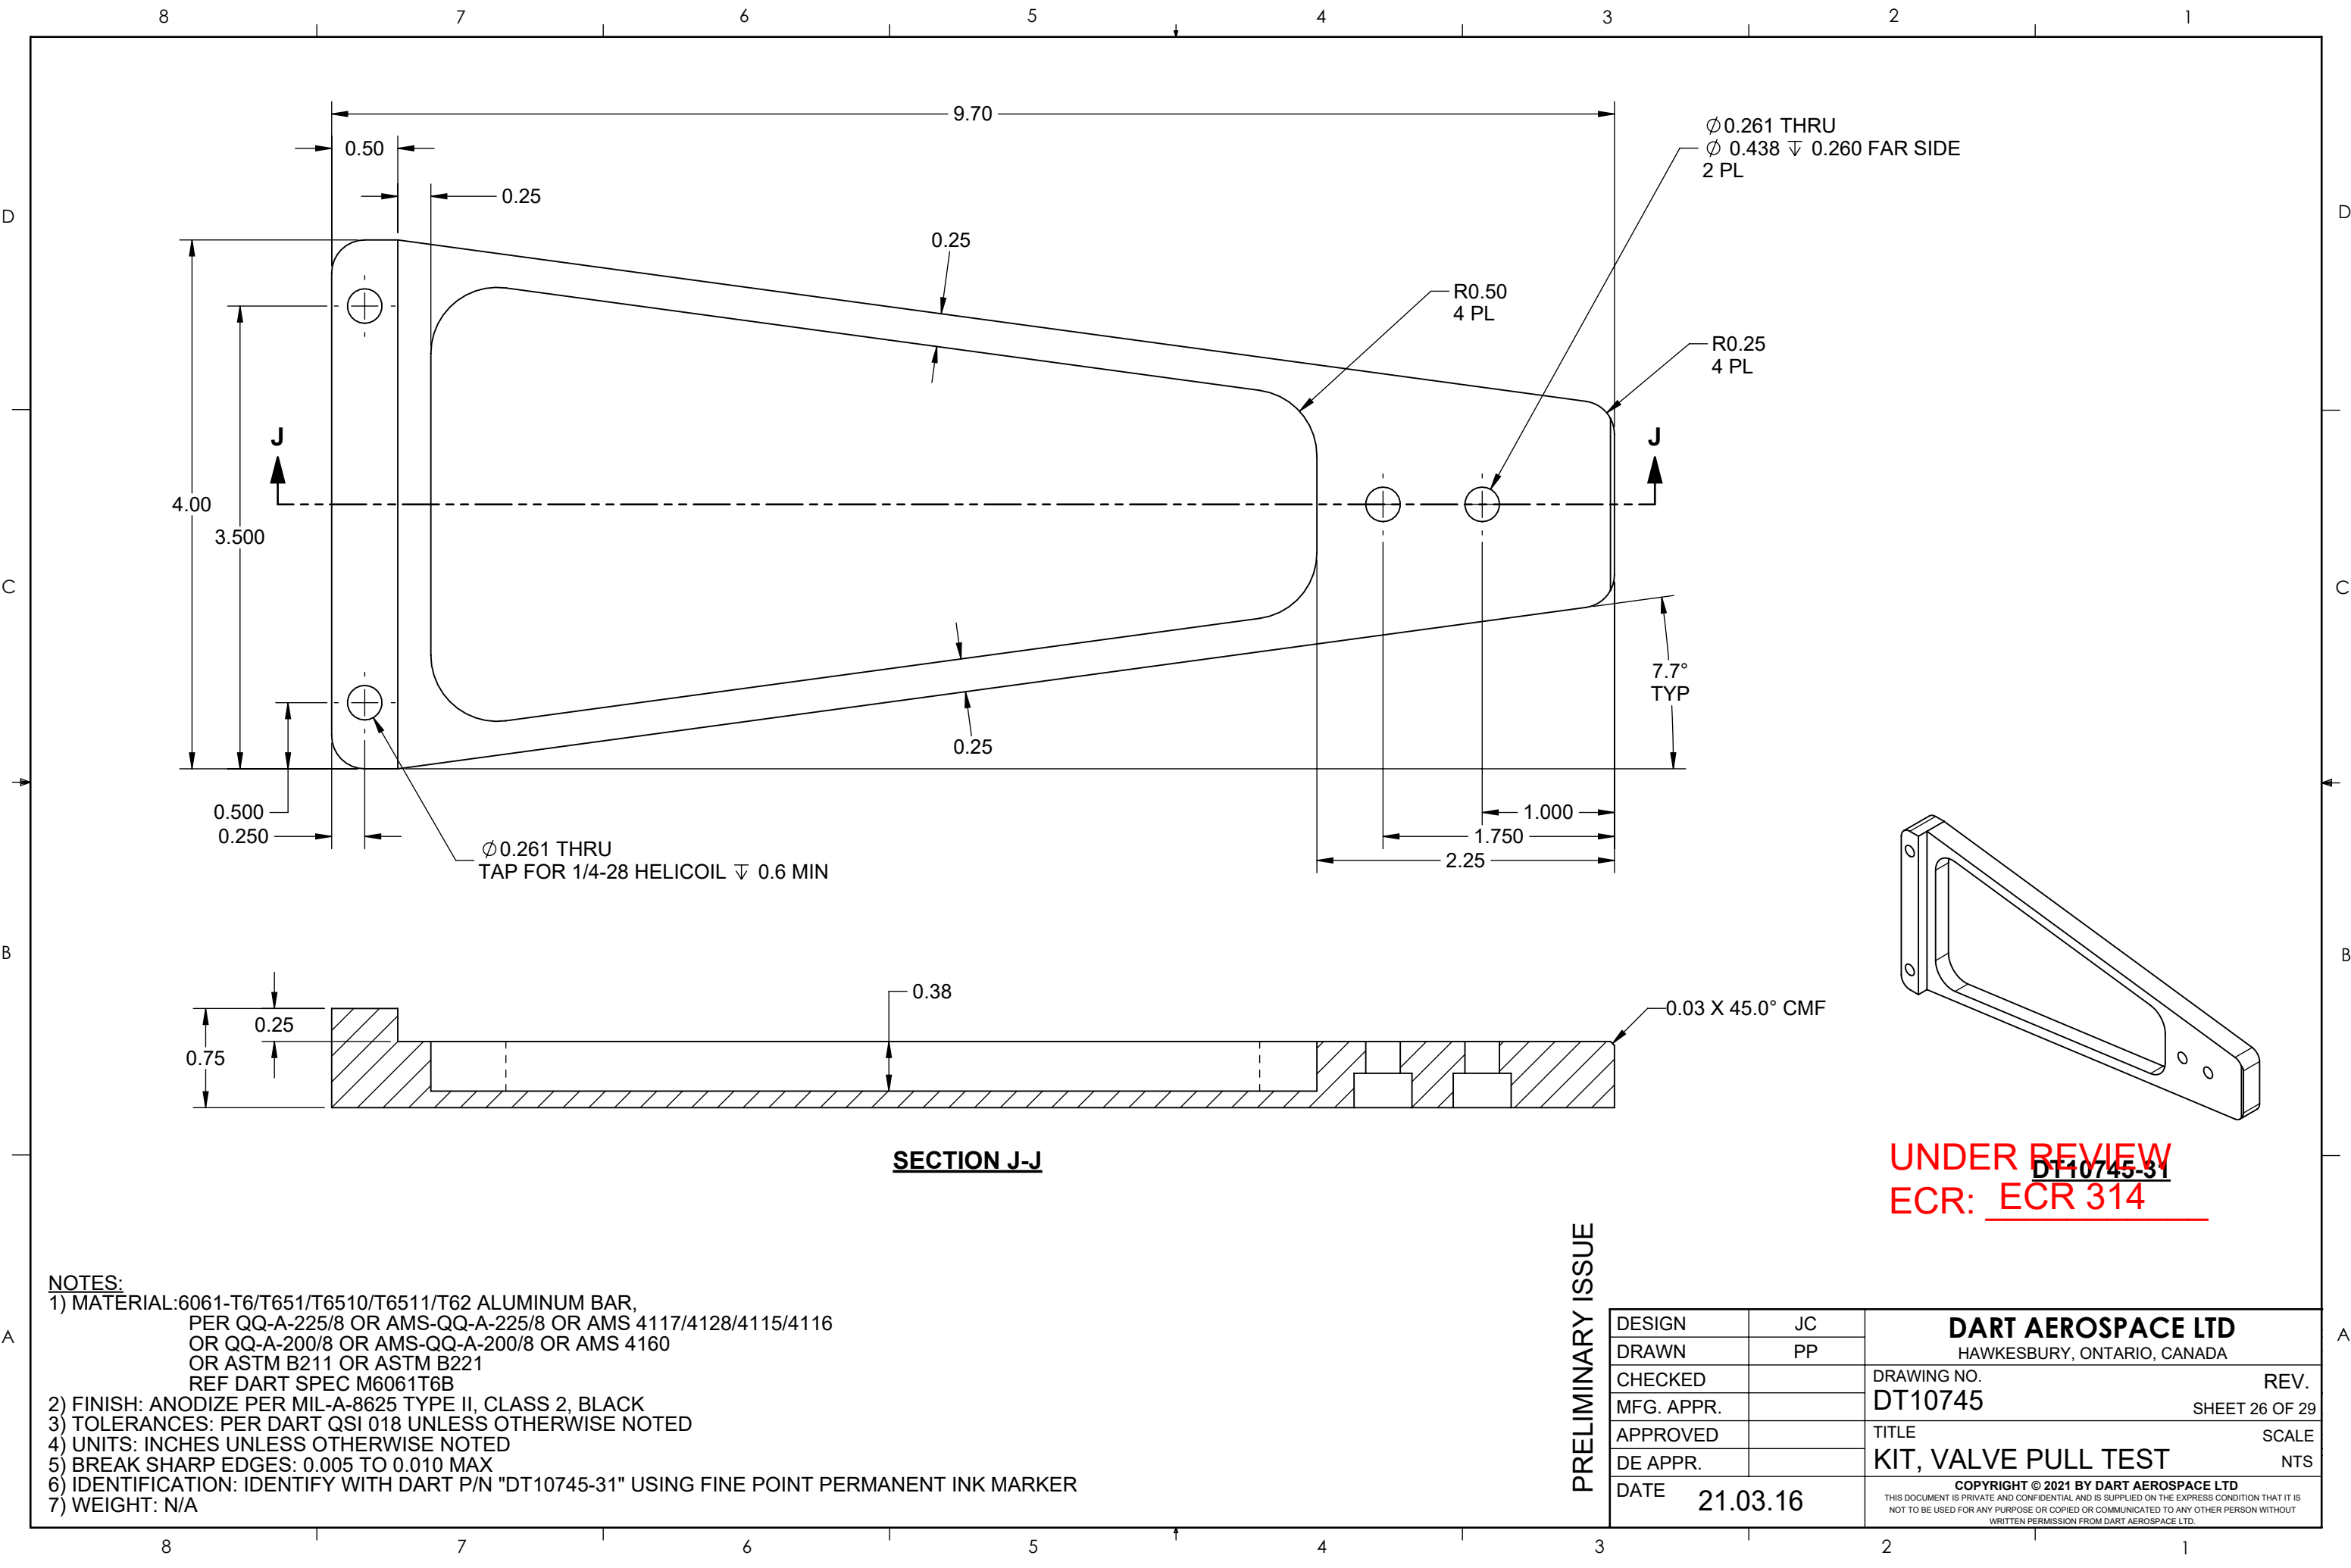


NOTES:
1) MATERIAL: 6061-T6/T651/T6510/T6511/T62 ALUMINUM BAR,
PER QQ-A-225/8 OR AMS-QQ-A-225/8 OR AMS 4117/4128/4115/4116
OR QQ-A-200/8 OR AMS-QQ-A-200/8 OR AMS 4160
OR ASTM B211 OR ASTM B221
REF DART SPEC M6061T6B
2) FINISH: ANODIZE PER MIL-A-8625 TYPE II, CLASS 2, BLACK
3) TOLERANCES: PER DART QSI 018 UNLESS OTHERWISE NOTED
4) UNITS: INCHES UNLESS OTHERWISE NOTED
5) BREAK SHARP EDGES: 0.005 TO 0.010 MAX
6) IDENTIFICATION: IDENTIFY WITH DART P/N "DT10745-31" USING FINE POINT PERMANENT INK MARKER
7) WEIGHT: N/A

PRELIMINARY ISSUE

DESIGN	JC	DART AEROSPACE LTD HAWKESBURY, ONTARIO, CANADA	
DRAWN	PP		
CHECKED		DRAWING NO.	REV.
MFG. APPR.		DT10745	SHEET 26 OF 29
APPROVED		TITLE	SCALE
DE APPR.		KIT, VALVE PULL TEST	NTS
DATE	21.03.16	COPYRIGHT © 2021 BY DART AEROSPACE LTD THIS DOCUMENT IS PRIVATE AND CONFIDENTIAL AND IS SUPPLIED ON THE EXPRESS CONDITION THAT IT IS NOT TO BE USED FOR ANY PURPOSE OR COPIED OR COMMUNICATED TO ANY OTHER PERSON WITHOUT WRITTEN PERMISSION FROM DART AEROSPACE LTD.	

UNDER REVIEW
ECR: ECR 314

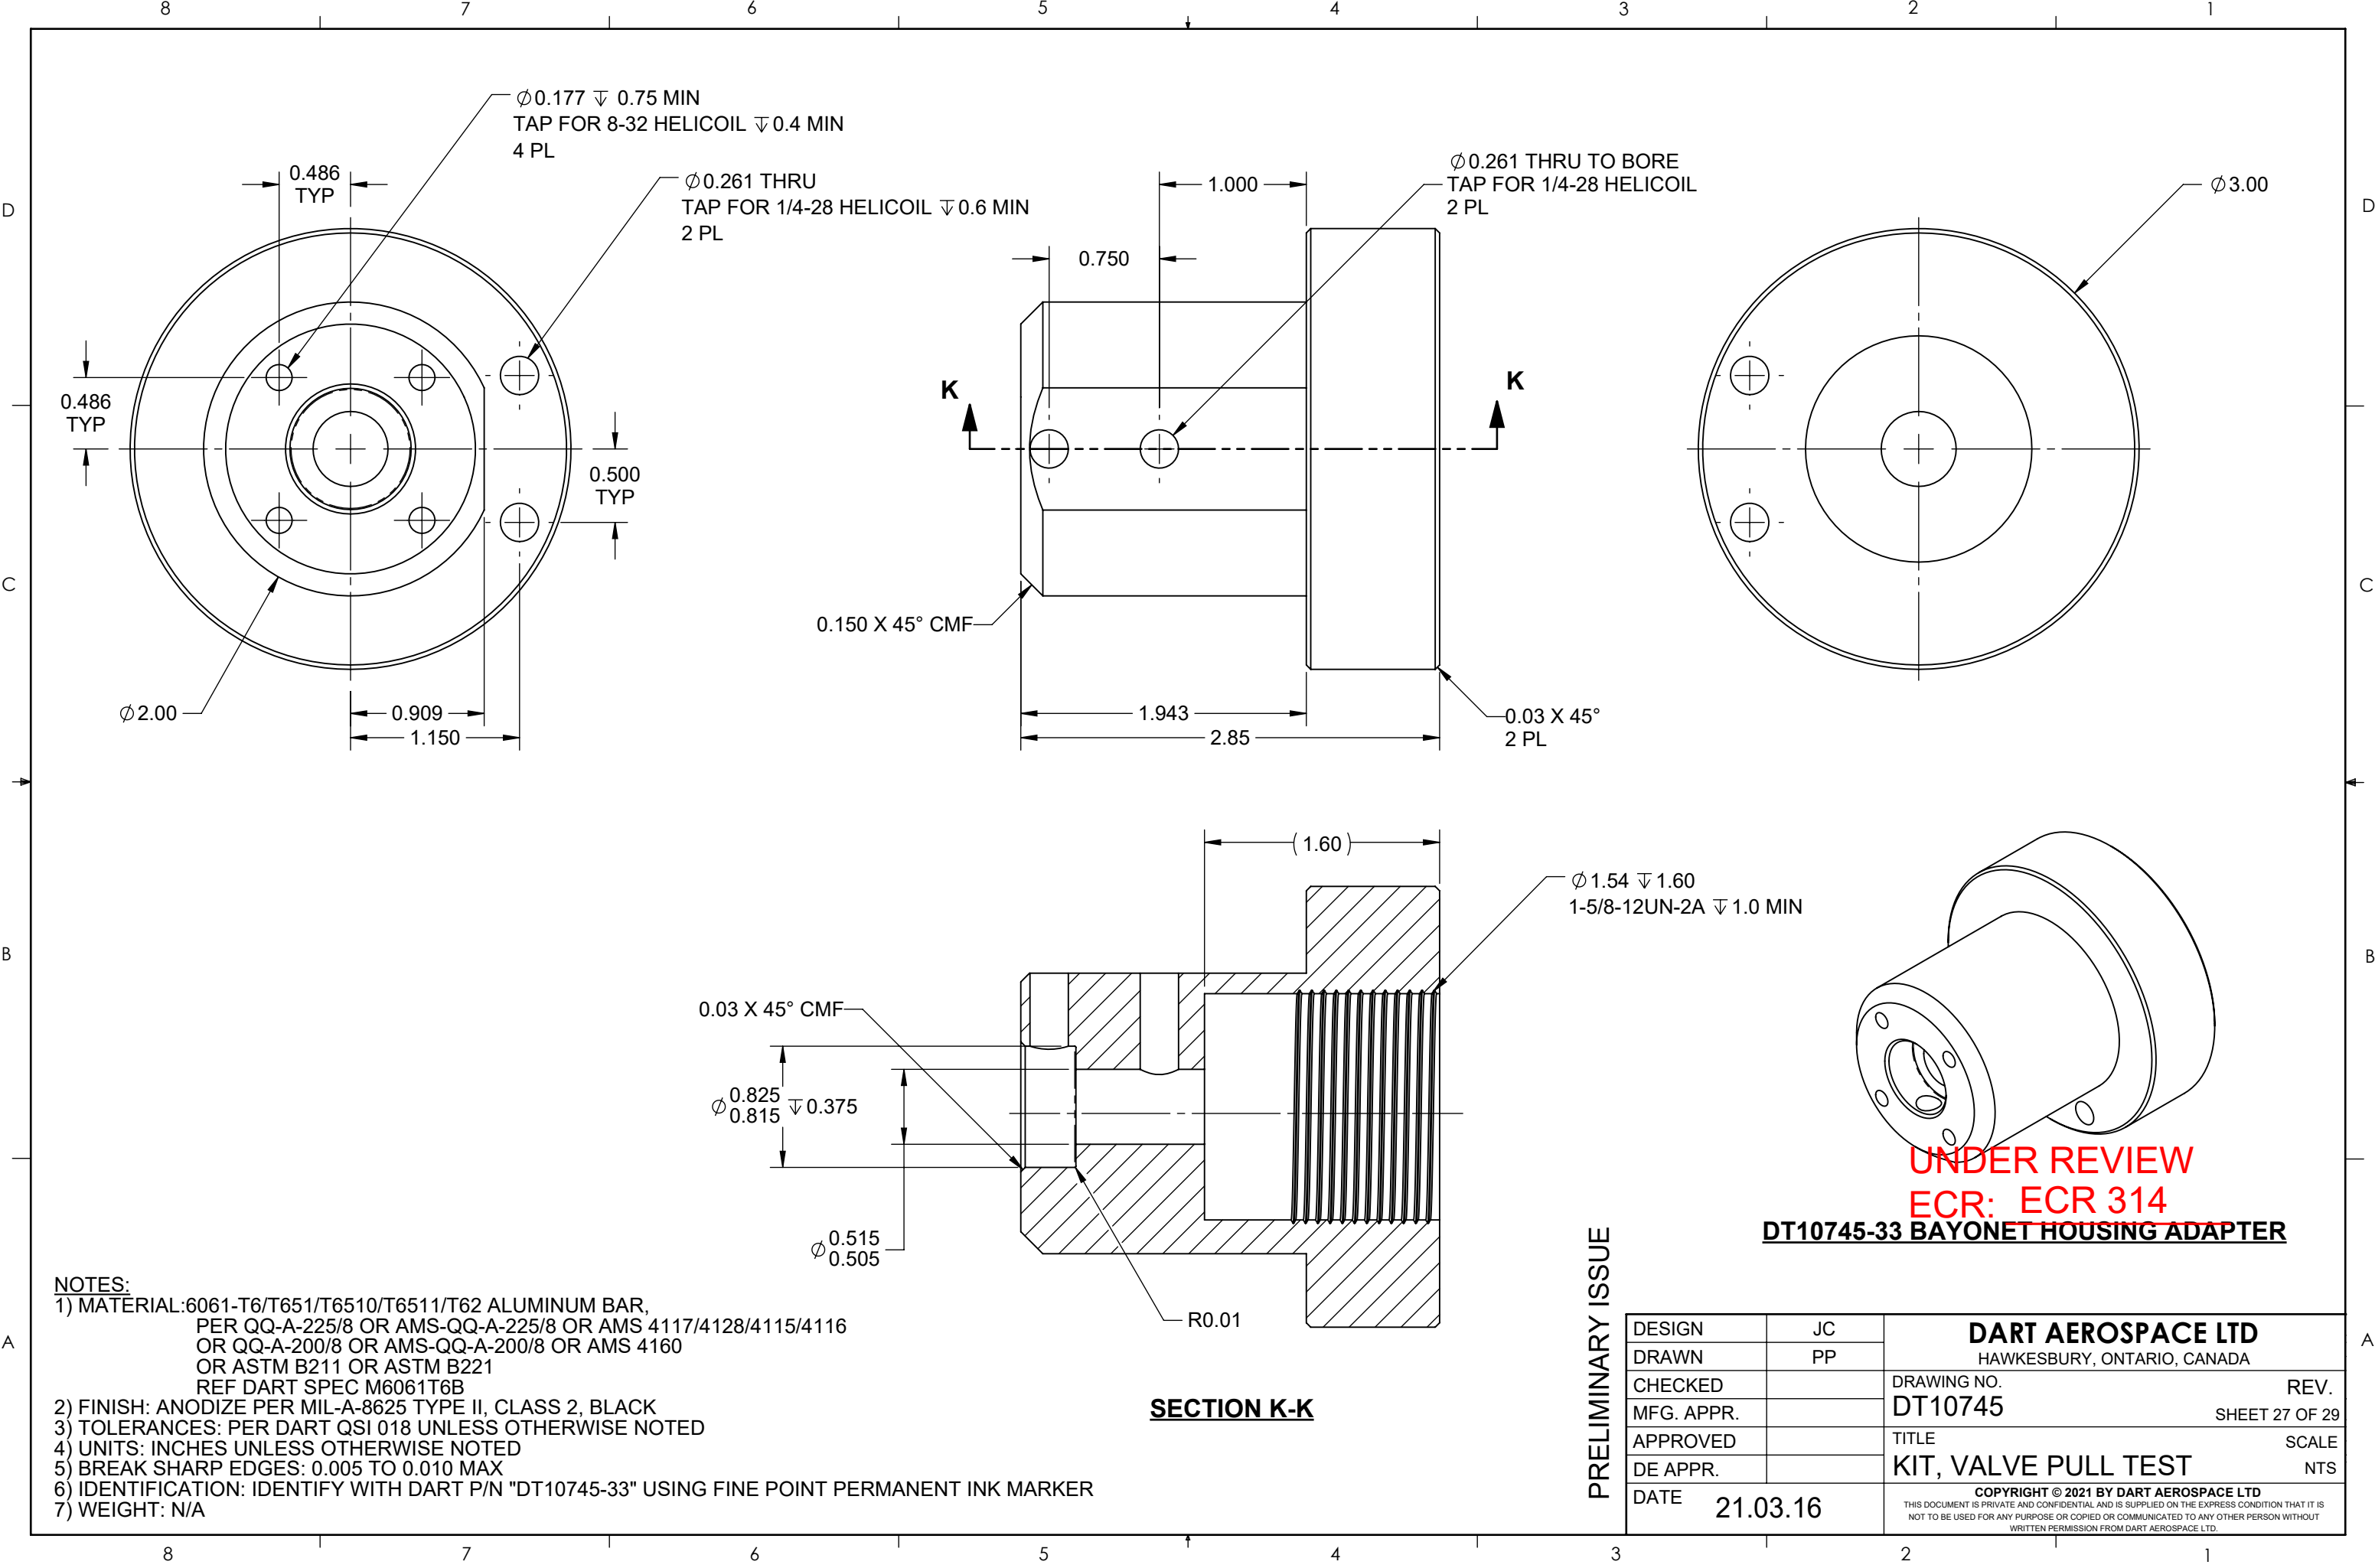

NOTES:

1) MATERIAL: 6061-T6/T651/T6510/T6511/T62 ALUMINUM BAR,
PER QQ-A-225/8 OR AMS-QQ-A-225/8 OR AMS 4117/4128/4115/4116
OR QQ-A-200/8 OR AMS-QQ-A-200/8 OR AMS 4160
OR ASTM B211 OR ASTM B221
REF DART SPEC M6061T6B

2) FINISH: ANODIZE PER MIL-A-8625 TYPE II, CLASS 2, BLACK

3) TOLERANCES: PER DART QSI 018 UNLESS OTHERWISE NOTED

4) UNITS: INCHES UNLESS OTHERWISE NOTED

5) BREAK SHARP EDGES: 0.005 TO 0.010 MAX

6) IDENTIFICATION: IDENTIFY WITH DART P/N "DT10745-33" USING FINE POINT PERMANENT INK MARKER


7) WEIGHT: N/A

SECTION K-K

PRELIMINARY ISSUE

DESIGN	JC	DART AEROSPACE LTD HAWKESBURY, ONTARIO, CANADA	
DRAWN	PP		
CHECKED		DRAWING NO. DT10745	REV.
MFG. APPR.			SHEET 27 OF 29
APPROVED		TITLE KIT, VALVE PULL TEST	SCALE NTS
DE APPR.		COPYRIGHT © 2021 BY DART AEROSPACE LTD <small>THIS DOCUMENT IS PRIVATE AND CONFIDENTIAL AND IS SUPPLIED ON THE EXPRESS CONDITION THAT IT IS NOT TO BE USED FOR ANY PURPOSE OR COPIED OR COMMUNICATED TO ANY OTHER PERSON WITHOUT WRITTEN PERMISSION FROM DART AEROSPACE LTD.</small>	
DATE	21.03.16		

QTY	P/N	DESCRIPTION	SUPPLIER
1	1789N15	ROCKER SWITCH, DPDT (REF)	MCMaster CARR
1	1789N326	CAP, ROCKER SWITCH, ARROWS (REF)	MCMaster CARR
6	7243K21	CONNECTOR, 1/4" FEMALE, SINGLE CRIMP	MCMaster CARR
1	6933K53 (BLK)	BANANA CONNECTOR (BLACK)	MCMaster CARR
1	6933K53 (RED)	BANANA CONNECTOR (RED)	MCMaster CARR
A/R		16 AWG WIRE	

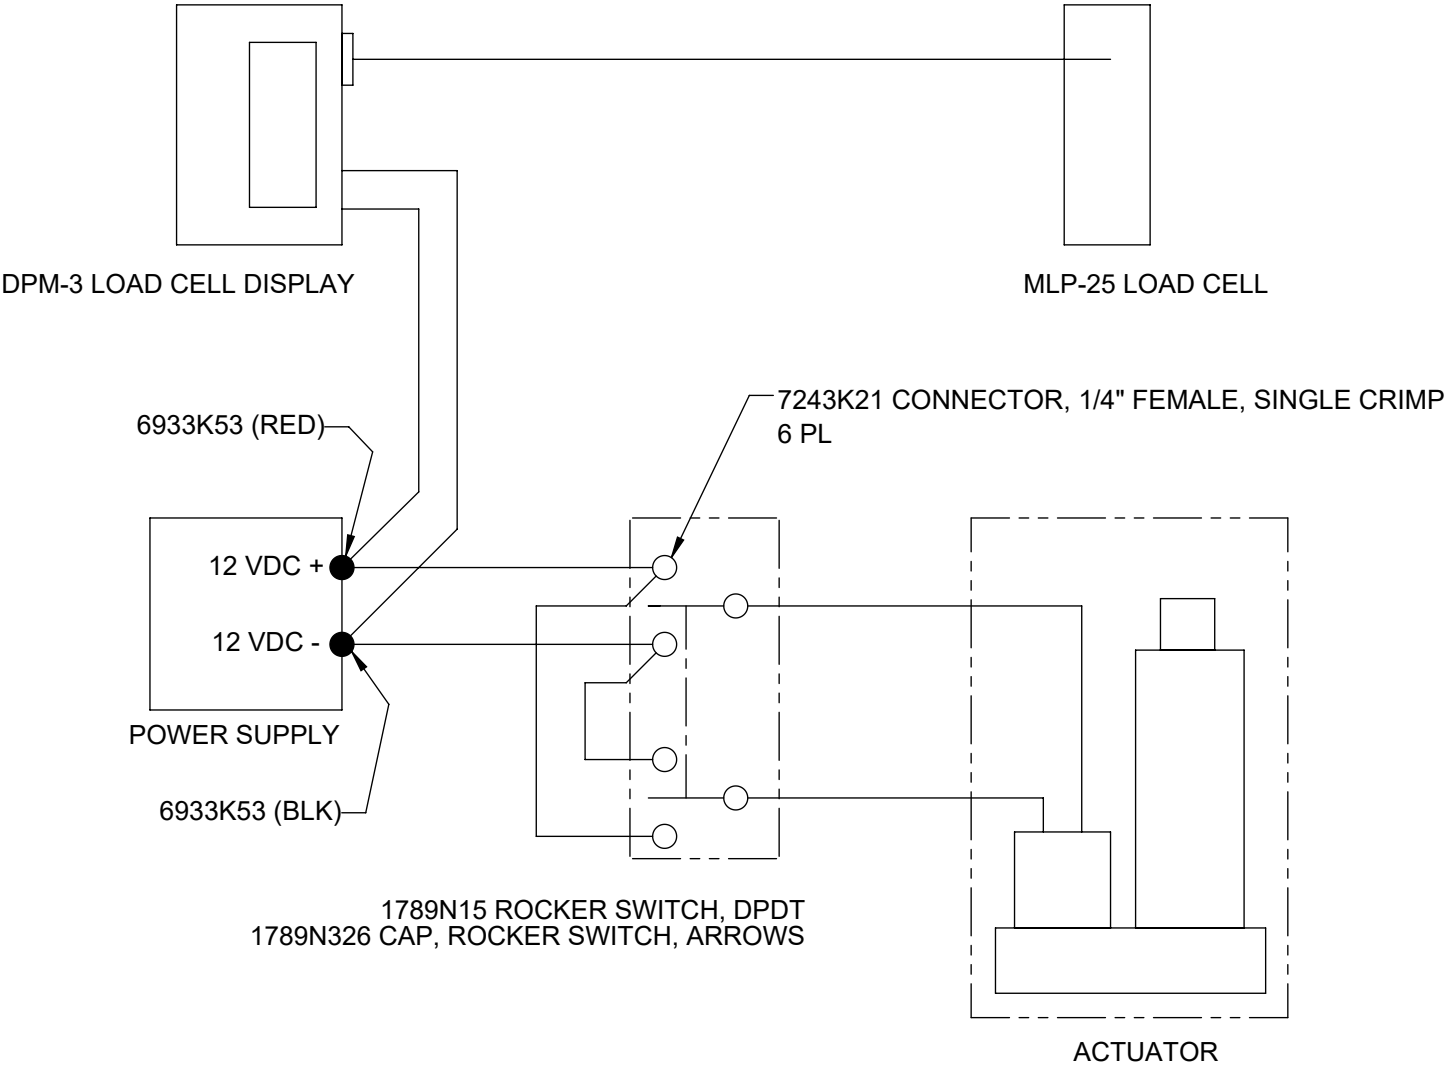

ELECTRICAL SCHEMATIC

UNDER REVIEW
ECR: ECR 314

- NOTES:
- 1) MATERIAL: N/A
 - 2) FINISH: N/A
 - 3) TOLERANCES: PER DART QSI 018 UNLESS OTHERWISE NOTED
 - 4) UNITS: INCHES UNLESS OTHERWISE NOTED
 - 5) BREAK SHARP EDGES: 0.005 TO 0.010 MAX
 - 6) IDENTIFICATION: NONE
 - 7) WEIGHT: N/A

PRELIMINARY ISSUE

DESIGN	JC	DART AEROSPACE LTD HAWKESBURY, ONTARIO, CANADA
DRAWN	PP	
CHECKED		DRAWING NO. REV.
MFG. APPR.		DT10745 SHEET 29 OF 29
APPROVED		TITLE SCALE
DE APPR.		KIT, VALVE PULL TEST NTS
DATE	21.03.16	COPYRIGHT © 2021 BY DART AEROSPACE LTD THIS DOCUMENT IS PRIVATE AND CONFIDENTIAL AND IS SUPPLIED ON THE EXPRESS CONDITION THAT IT IS NOT TO BE USED FOR ANY PURPOSE OR COPIED OR COMMUNICATED TO ANY OTHER PERSON WITHOUT WRITTEN PERMISSION FROM DART AEROSPACE LTD.